


T. 6 S. R. 7 W. W. M.

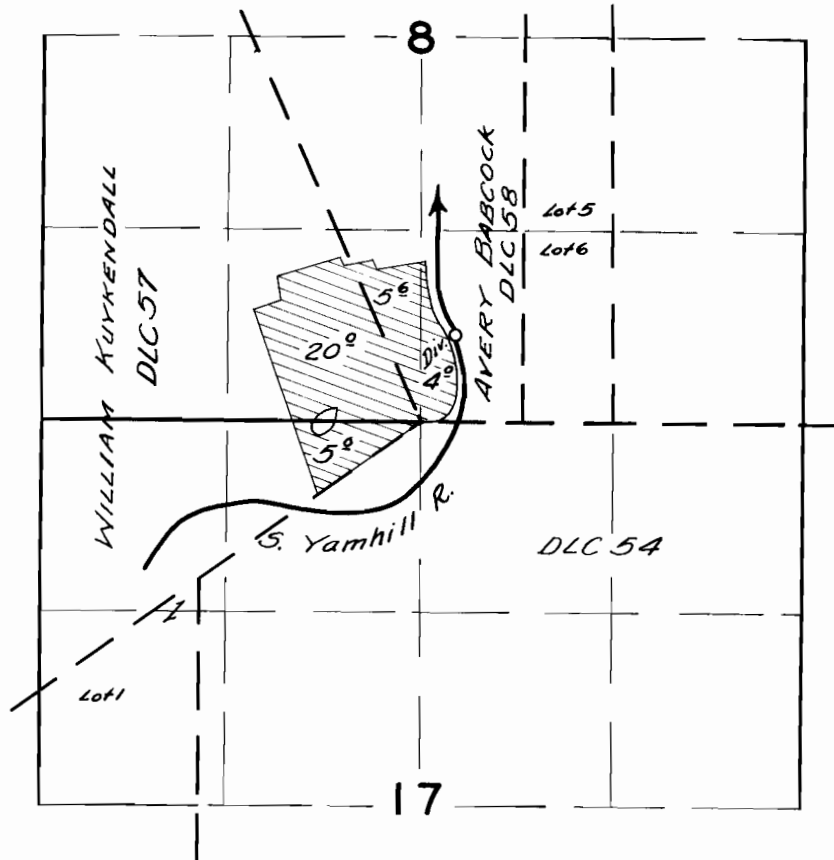

FINAL PROOF SURVEY
UNDER

Application No. *31389* Permit No. *24747*
IN NAME OF

Walter W. Werth

Surveyed *June 22, 1960*, by *C. O. Bastels*