


T. 1 S. R. 1 W. W.M.

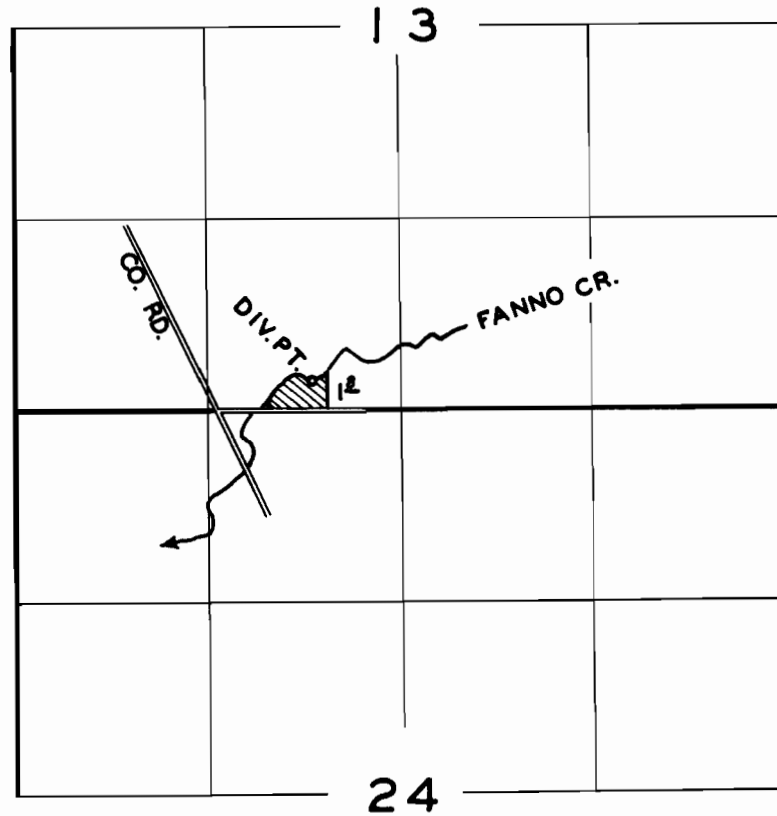

FINAL PROOF SURVEY
UNDER

Application No. 29658 Permit No. 23357
IN NAME OF

..... DONALD J. & ALDIS CLULOW

Surveyed JULY 7, 1960, by G.O. BARTELS.....