


# T. 1 S. R. 4 W. W. M.

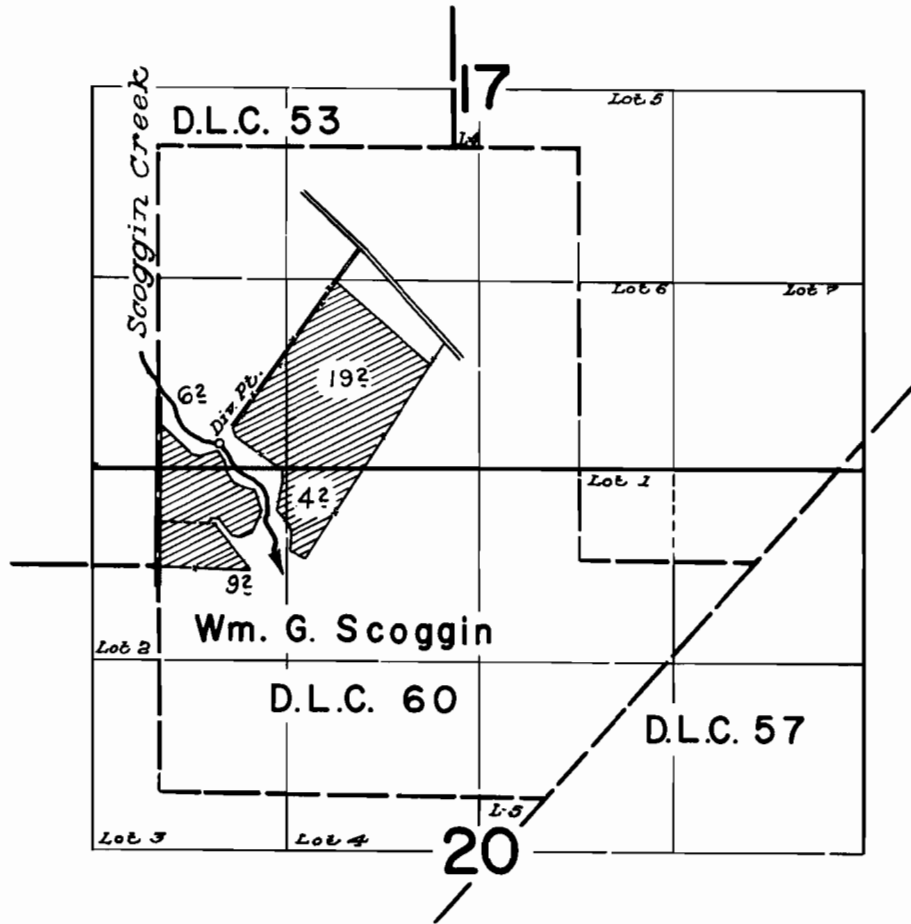

## FINAL PROOF SURVEY UNDER

Application No. 31116... Permit No. 24545  
IN NAME OF

G.E. & Margie Groneman

Surveyed July 5, 1960, by *[Signature]*