


T. 1 N. R. 4 W. W. M.

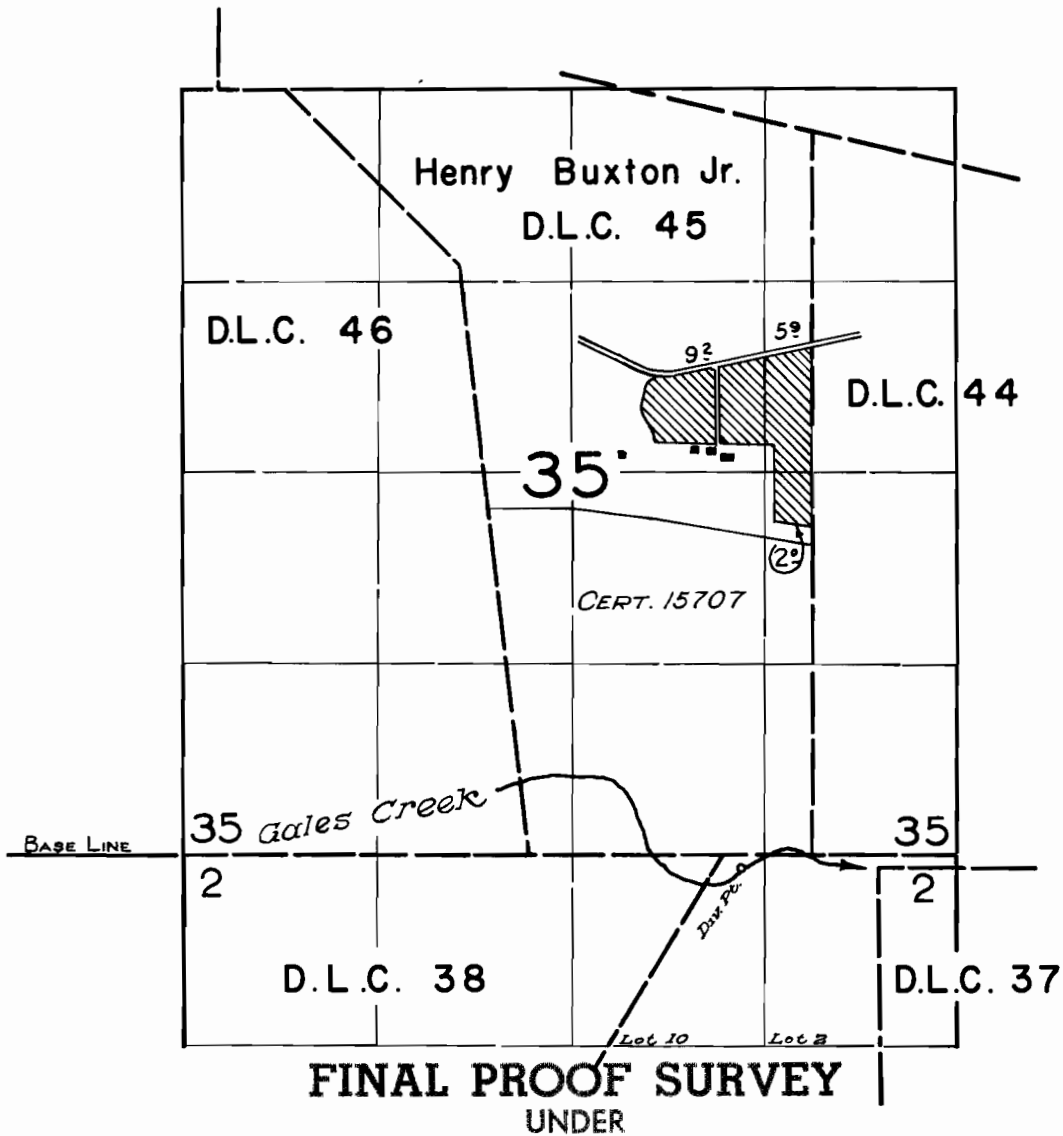

Application No. 32187. Permit No. 25393.  
IN NAME OF

**THE RUETER FARM**

Surveyed August 4 1960, by *[Signature]*