


T.2N. R.3 W.W.M.

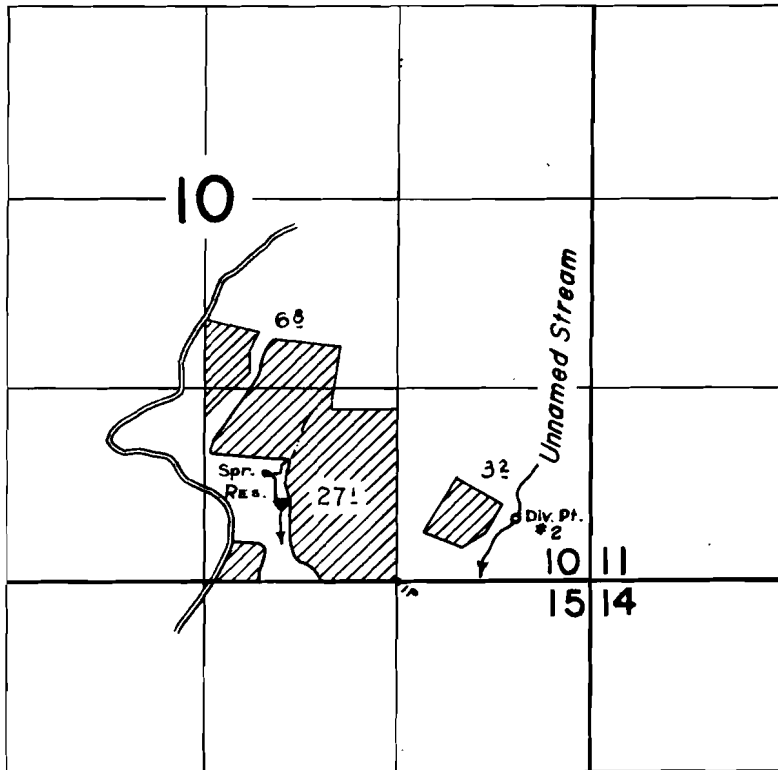

FINAL PROOF SURVEY
UNDER

R-33658 R-2320
Application No. 33308. Permit No. 26543.
IN NAME OF

Walter Baggentos

Surveyed Sept. 7, 1960, by *A. Jackson*