


T.4 S.R.3 W.W.M.

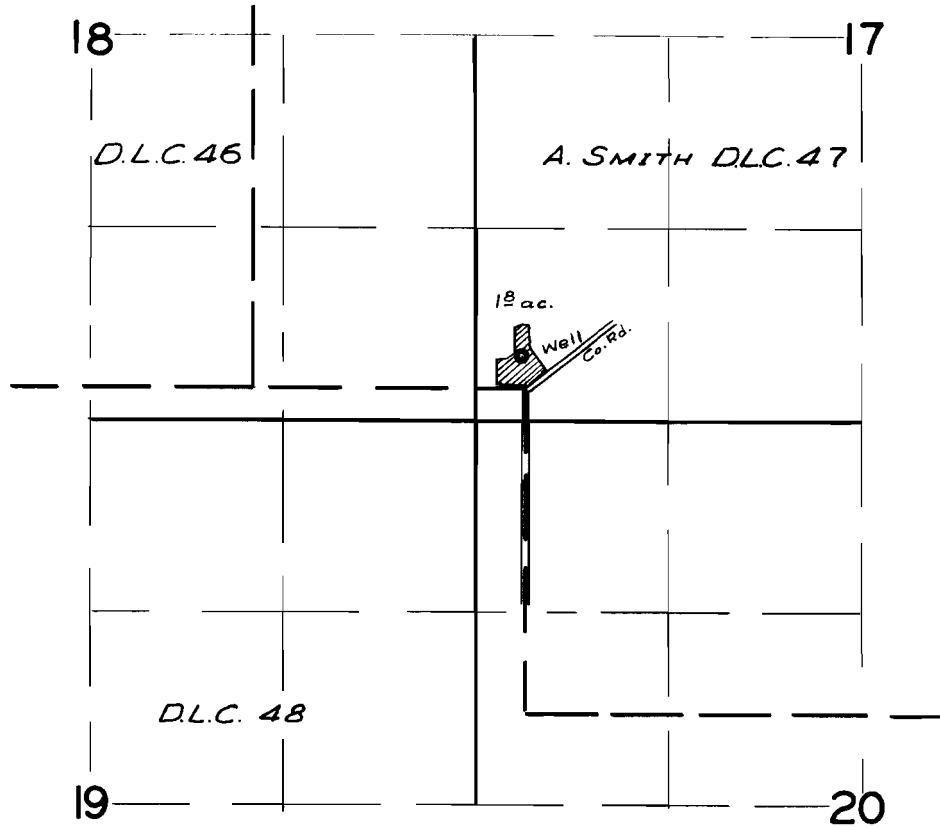

FINAL PROOF SURVEY UNDER

Application No. G-183 Permit No. G-89
IN NAME OF

OSCAR DOWER

Surveyed 25 MAY 1960 by m. Bick