


T.3 S.R.2 W.W.M.

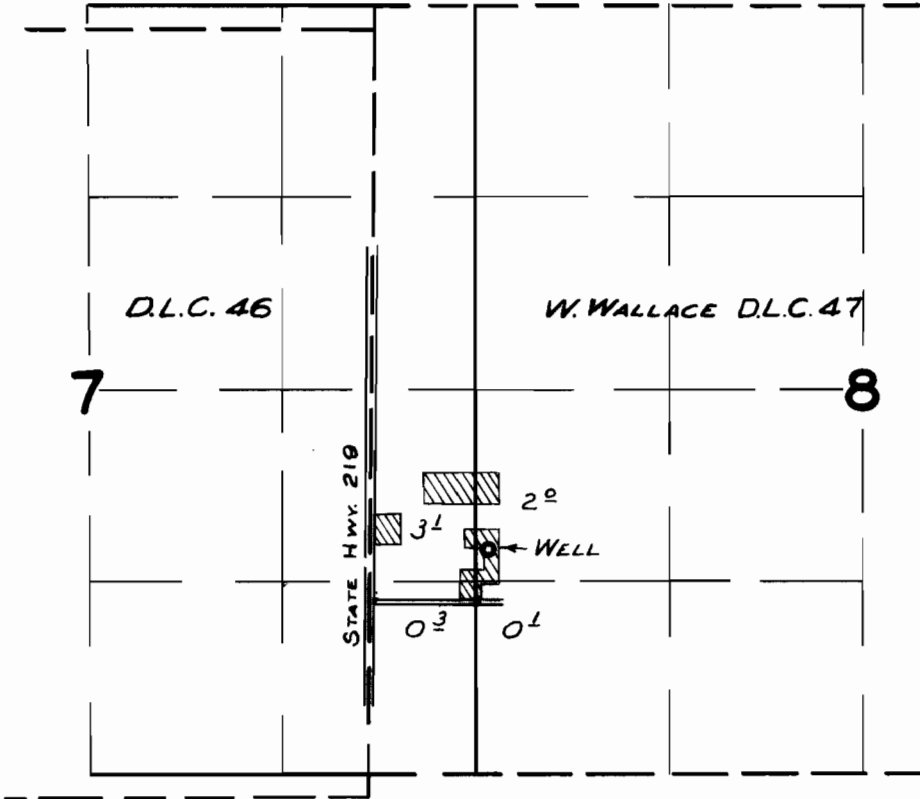

FINAL PROOF SURVEY
UNDER

Application No. G-462 Permit No. G-369
IN NAME OF

ERNEST P. SASSE

Surveyed 3 JUNE 1960, by Mr. Bish