


T.5 S.R.3 W.W.M.

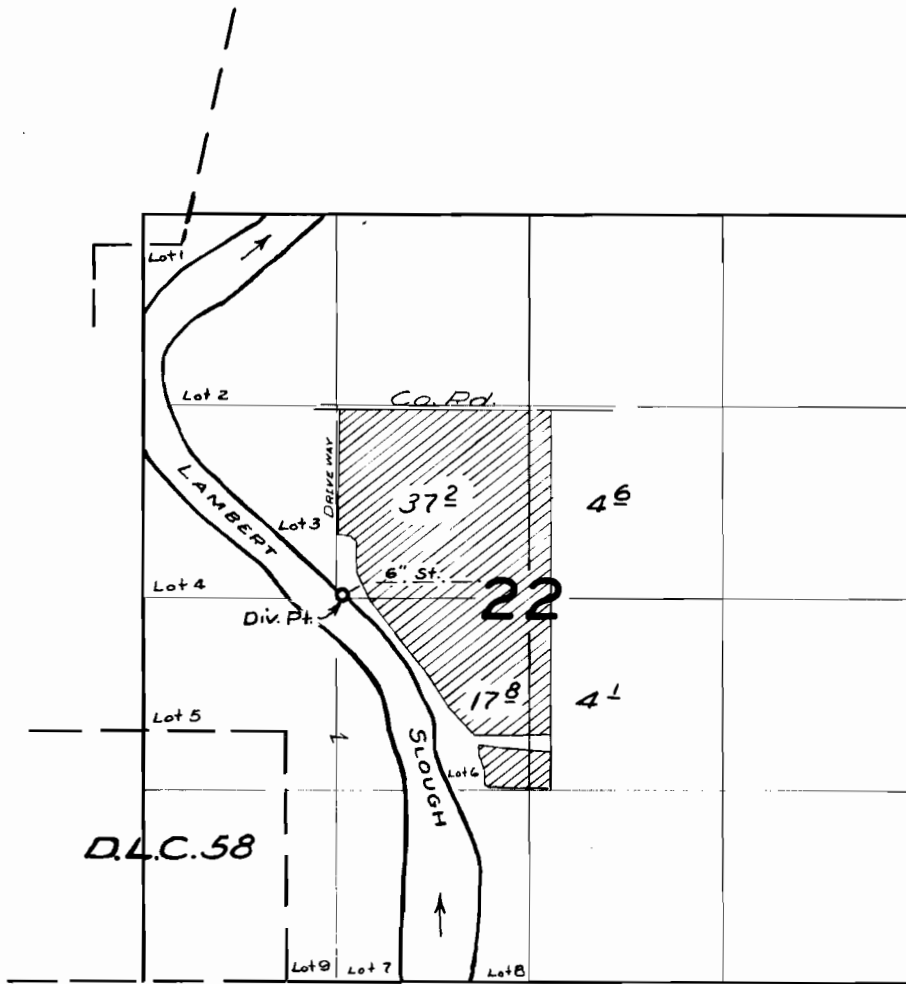

FINAL PROOF SURVEY  
UNDER

Application No. 32377 Permit No. 25566  
IN NAME OF

VICTOR SCOGGAN

Surveyed 1 JUNE 1960, by M. Bick