


T.13S. R.44E.W.M.

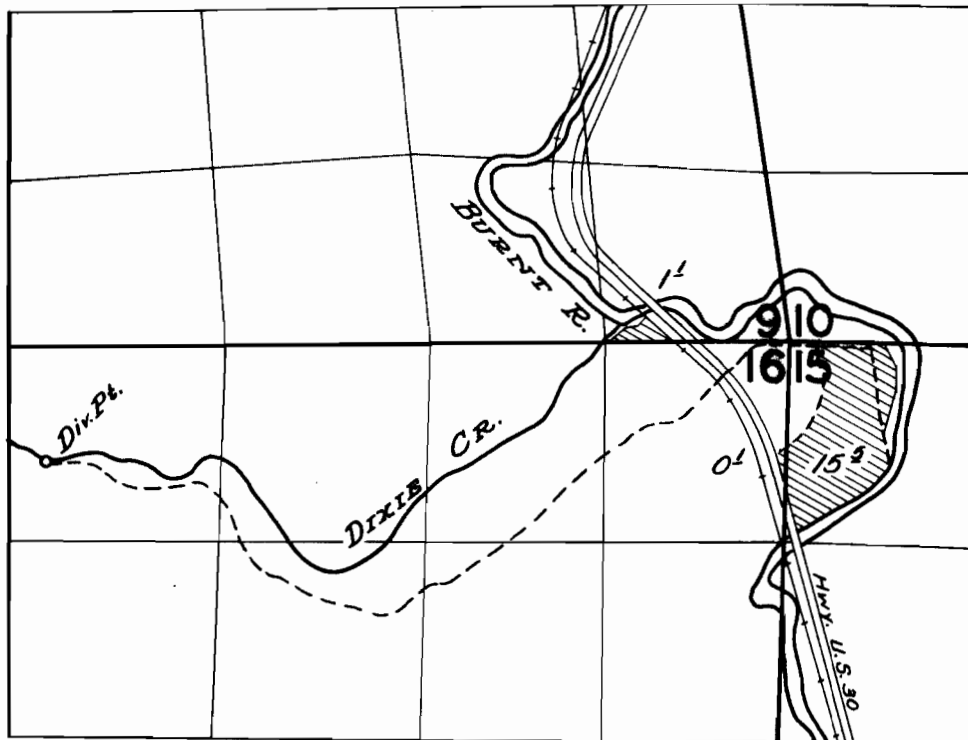

FINAL PROOF SURVEY
UNDER

Application No. 32041... Permit No. 25289..
IN NAME OF

.....HAZEL GERTRUDE LANGLEY.....

Surveyed Sept. 17, 1960, by C.O. Daulton.....