


# T. 12S. R. 5W. W.M.

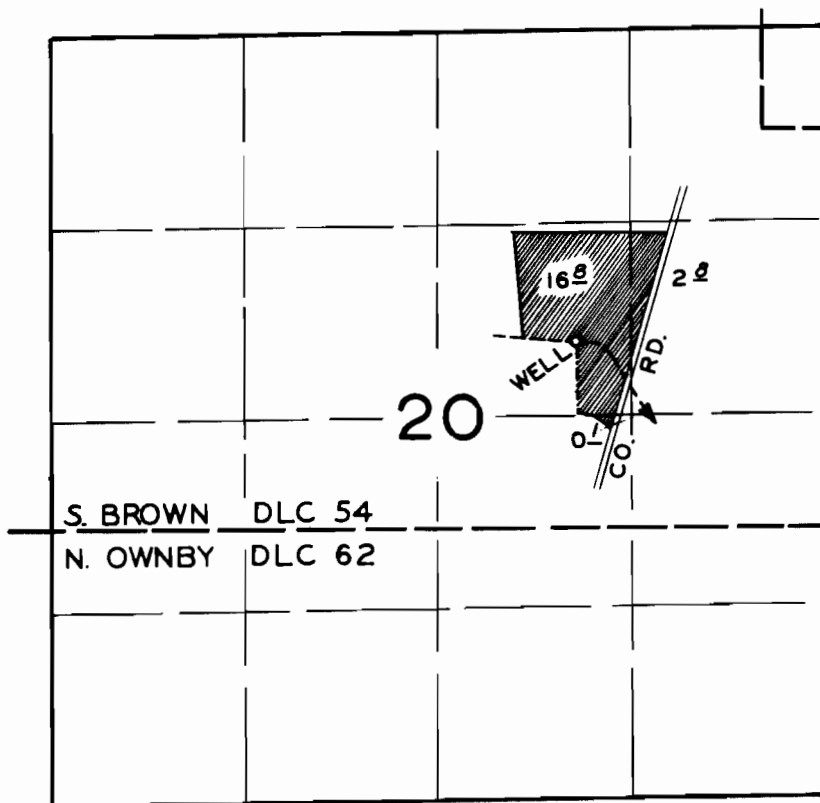

## FINAL PROOF SURVEY UNDER

Application No. G-457 Permit No. G-309  
IN NAME OF

C. A. McDonald

Surveyed JULY 27, 1960, by