


T. 12S. R. 5W. W.M.

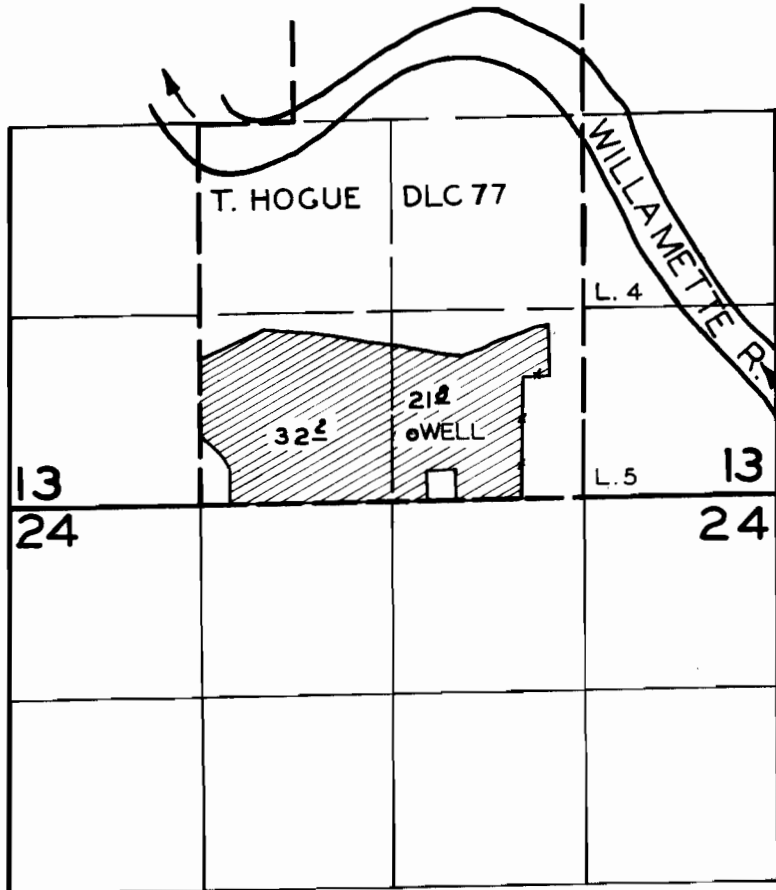

FINAL PROOF SURVEY
UNDER

Application No. G 719 Permit No. G624
IN NAME OF

EARL B. HATHAWAY

Surveyed JULY 29 1960, by

[Handwritten Signature]