


T.5S.R.2E.W.M.

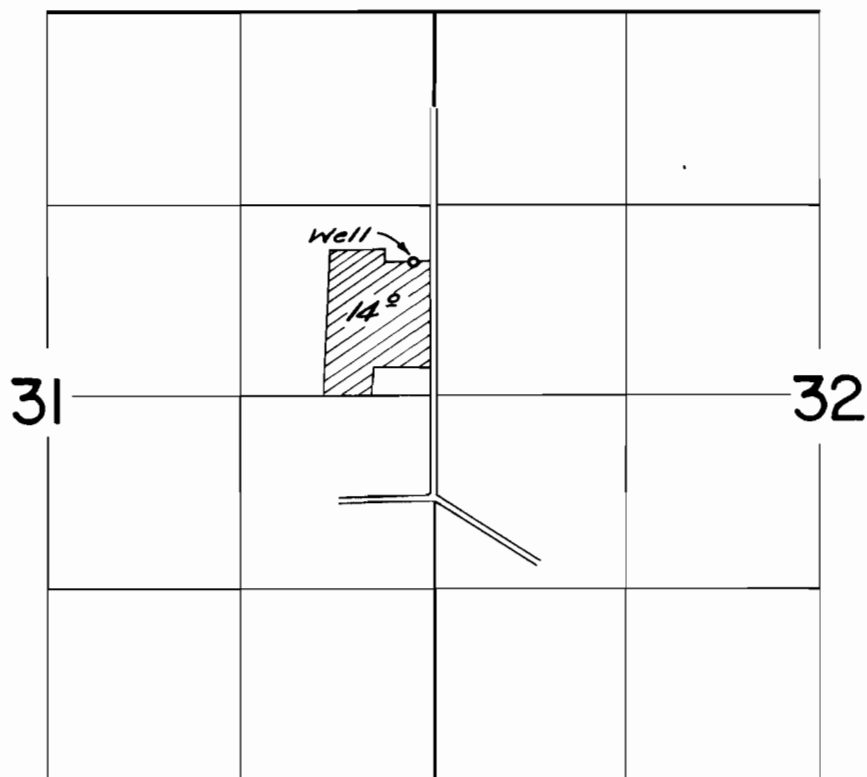

FINAL PROOF SURVEY
UNDER

Application No. *G-1375* Permit No. *G-1248*
IN NAME OF

DEWAYNE E. & DOROTHY GUILD

Surveyed *Sept. 9* 1960, by *C.D. Bartels*