


T.3S. R.1E.W.M.

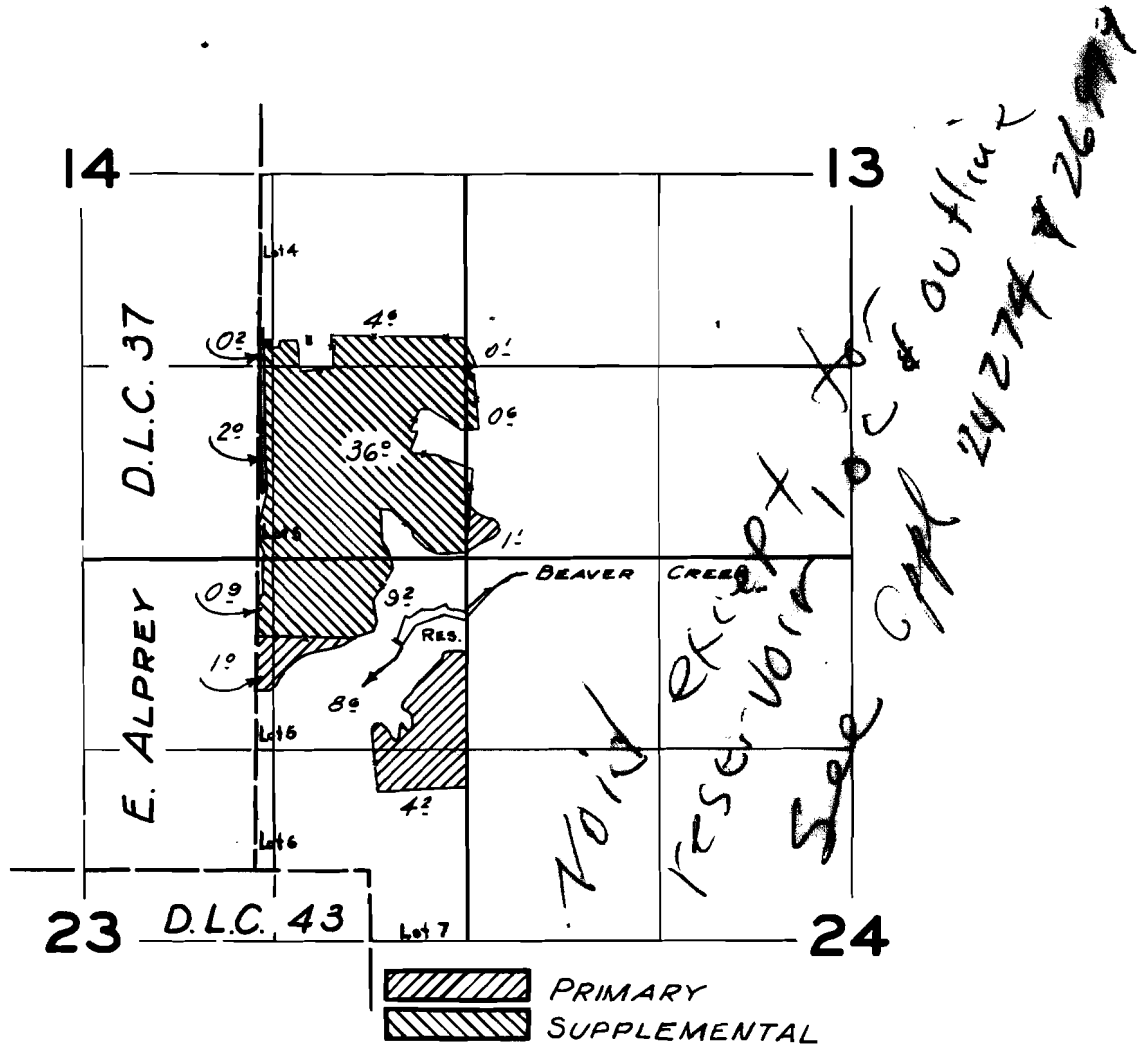

FINAL PROOF SURVEY
UNDER

R-29191 R-1648
Application No. 29192 Permit No. 23070
IN NAME OF

GEORGE GOULD & NORMAN J. PANTENBERG

Surveyed Oct. 7, 1958, by C. O. Bartels
Mar. 28 1960 R. H. Jackson