


T.3S. R.1E.W.M.

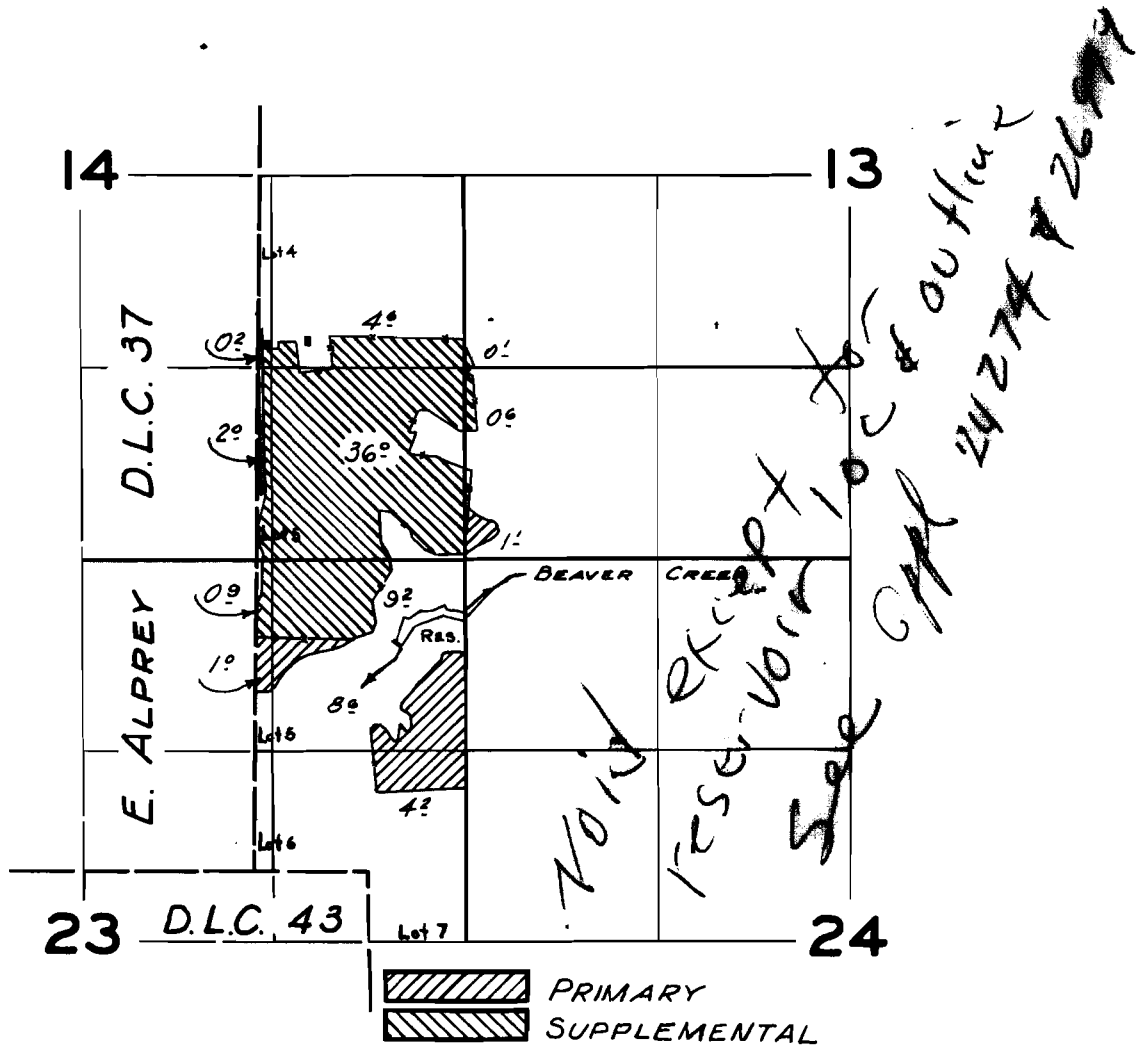

FINAL PROOF SURVEY UNDER

Application No. R-29191 2919.2 Permit No. R-1648 2307.0
IN NAME OF

GEORGE GOULD & NORMAN J. PANTENBERG

Surveyed Oct. 7 1958, by C. O. Bartels
Mar. 28 1960 R. H. Jackson