


T.2S.R.4E.W.M.

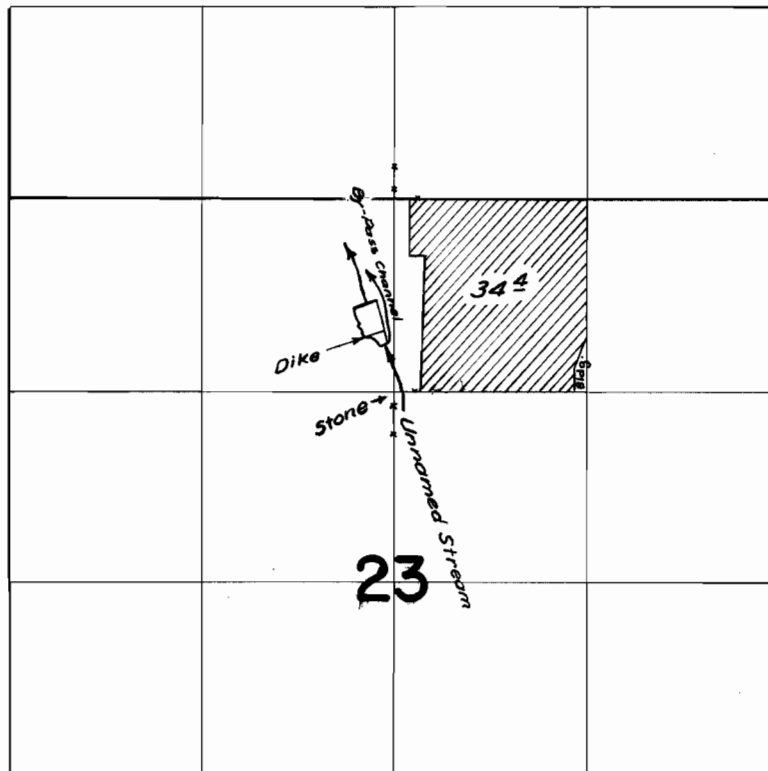

FINAL PROOF SURVEY
UNDER

Application No. ²⁹²⁷²R-29271 Permit No. ²³²⁶⁵R-1689
IN NAME OF

CHILTON & SON

Surveyed 26 AUG. 1960 by M. B. Bish

DFK-6P-52
1960-A