


T.2S.R.4E.W.M.

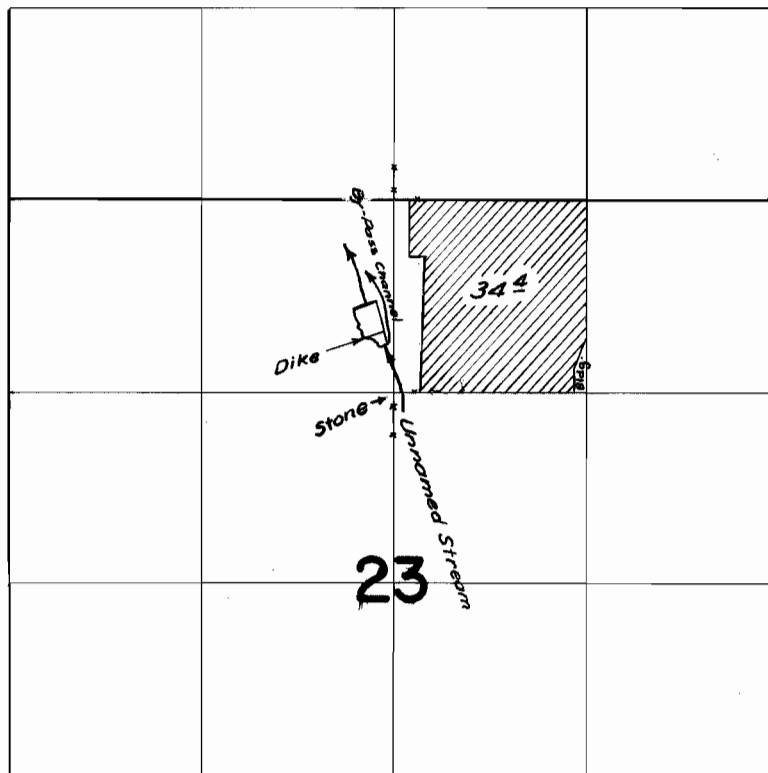

FINAL PROOF SURVEY
UNDER

Application No. 29272 R-29271 Permit No. 23265 R-1689
IN NAME OF

CHILTON & SON

Surveyed 26 Aug. 1960 by M. B. [Signature]

DFK-6D-52
1960-A