


T.2 S.R.4 E.W.M.

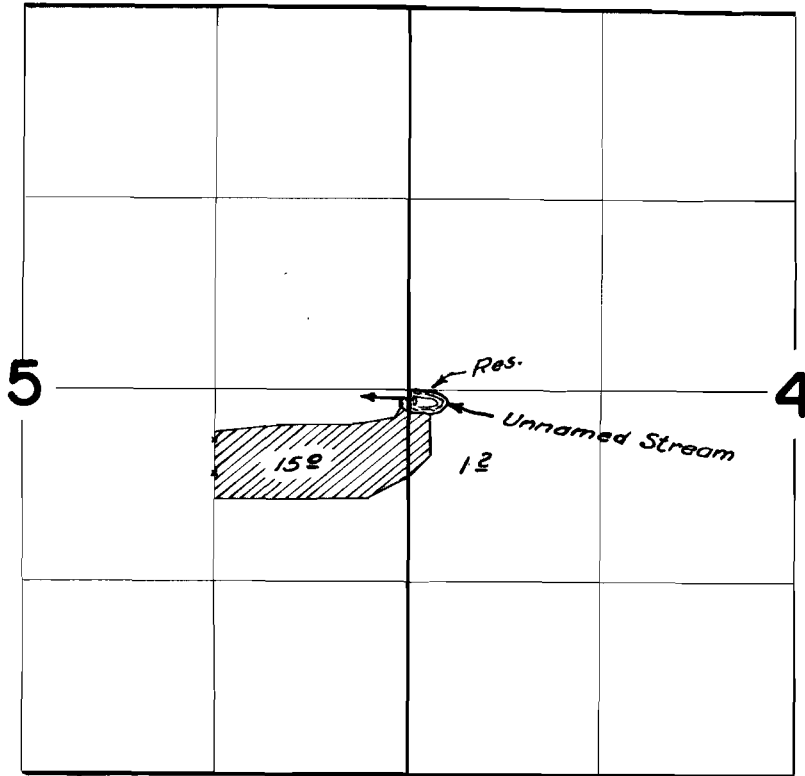

FINAL PROOF SURVEY UNDER

Application No. 30282 P-30281 Permit No. 23726 P-1770
IN NAME OF

H. C. & JULIA M. COMPTON

Surveyed 22 Aug. 1960, by T. M. Bish