


T.2 S.R.4 E.W.M.

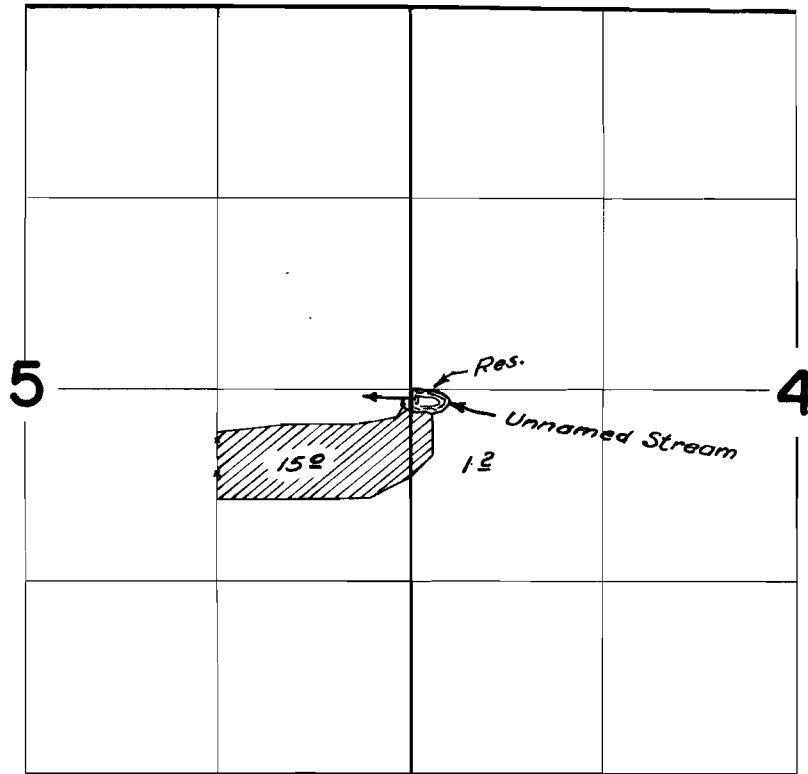

FINAL PROOF SURVEY UNDER

Application No. 30282 Permit No. 23726
R-30281 R-1770
IN NAME OF

H. C. & JULIA M. COMPTON

Surveyed 22 Aug 1960, by M. Bish