


T.8N.R.10W.W.M.

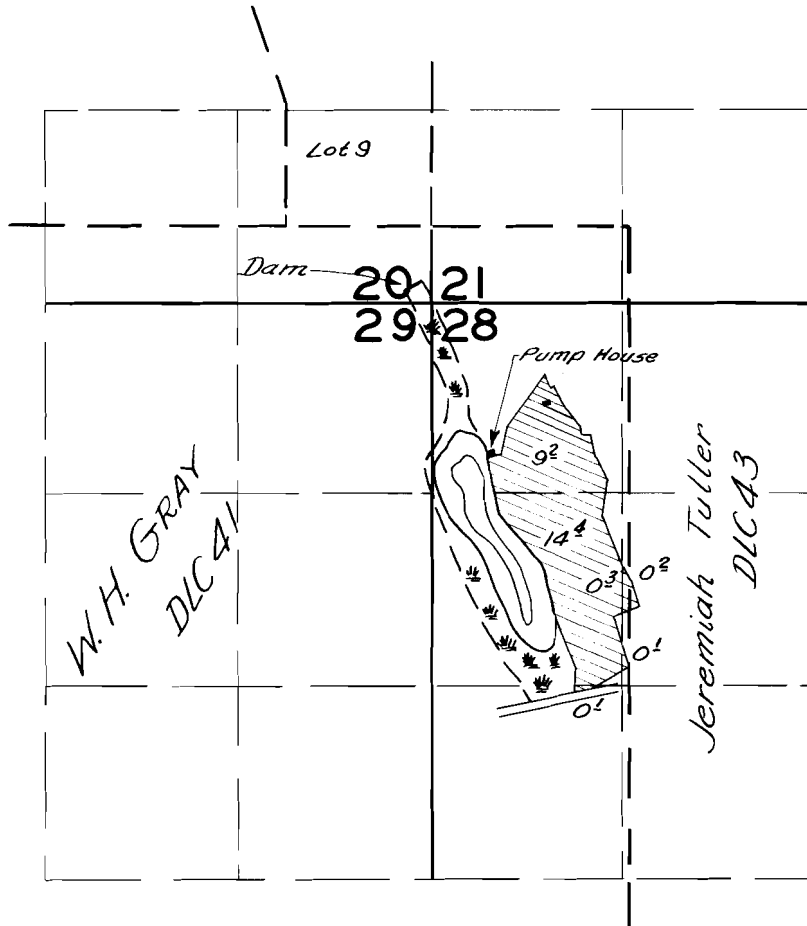

FINAL PROOF SURVEY
UNDER

Application No. ¹¹⁶³²_{R-18269} ⁸⁰⁹⁶_{R-735} Permit No. ₁₈₃₃₆ ₁₃₉₆₉
IN NAME OF

CITY OF ASTORIA

Surveyed July 14, 1960, by G.O. Baiter