


T.6N. R.5W.W.M.

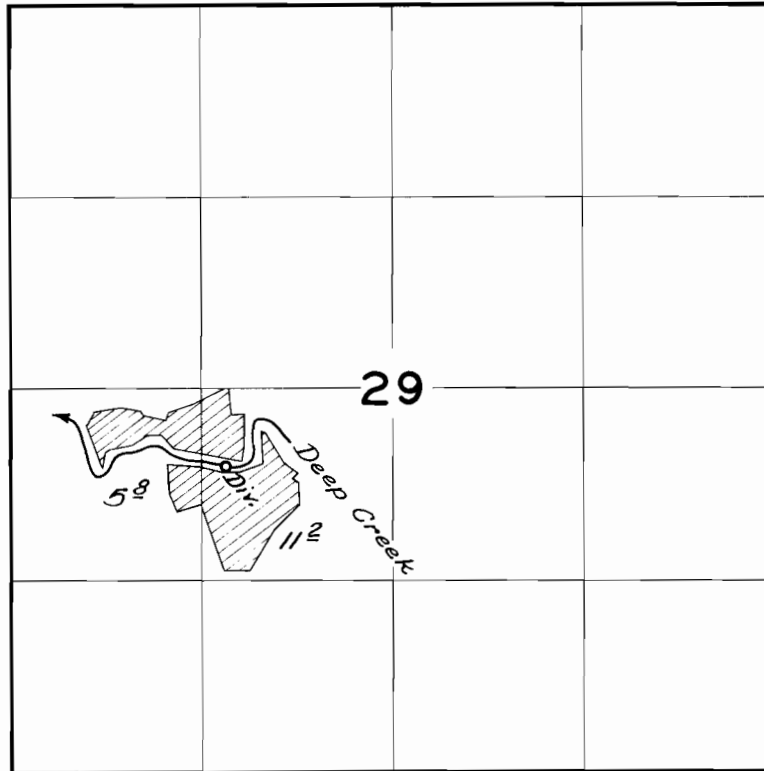

**FINAL PROOF SURVEY**  
UNDER

Application No. 25078 Permit No. 19741.....  
IN NAME OF

..... *C. C. Manns* .....

Surveyed *July 12*, 1960, by *C. O. Baite*.....