


T. 3N. R. 2W. W.M.

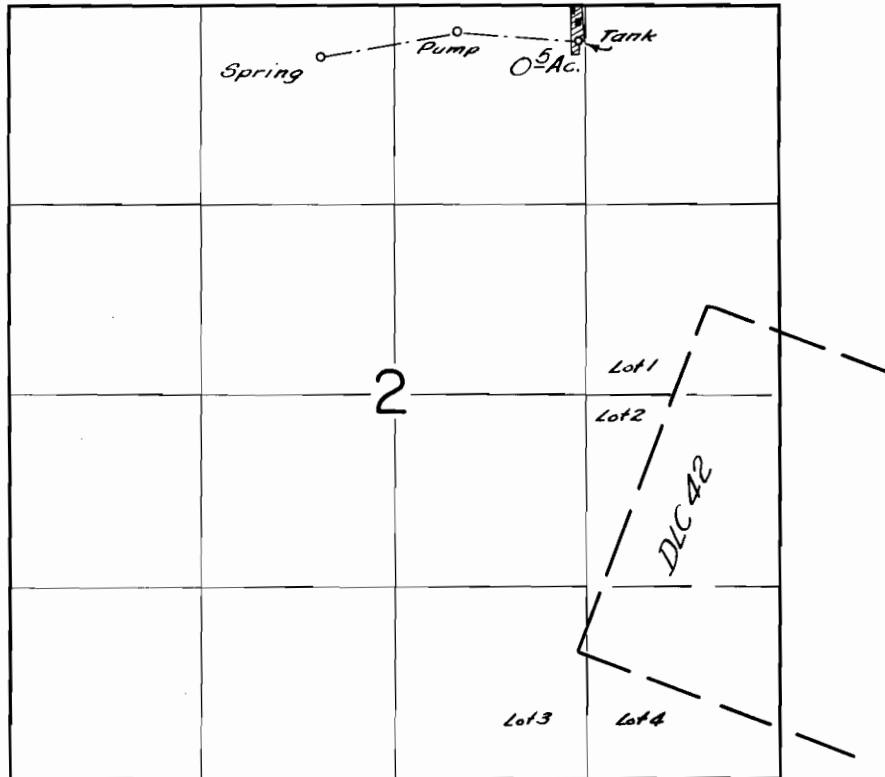

**FINAL PROOF SURVEY**  
UNDER

Application No. 26579 Permit No. 21010  
IN NAME OF

MELVIN R. JOHNSON

Surveyed July 21, 1960, by C.O. Bartels