


T.4N.R.1&2W.W.M.

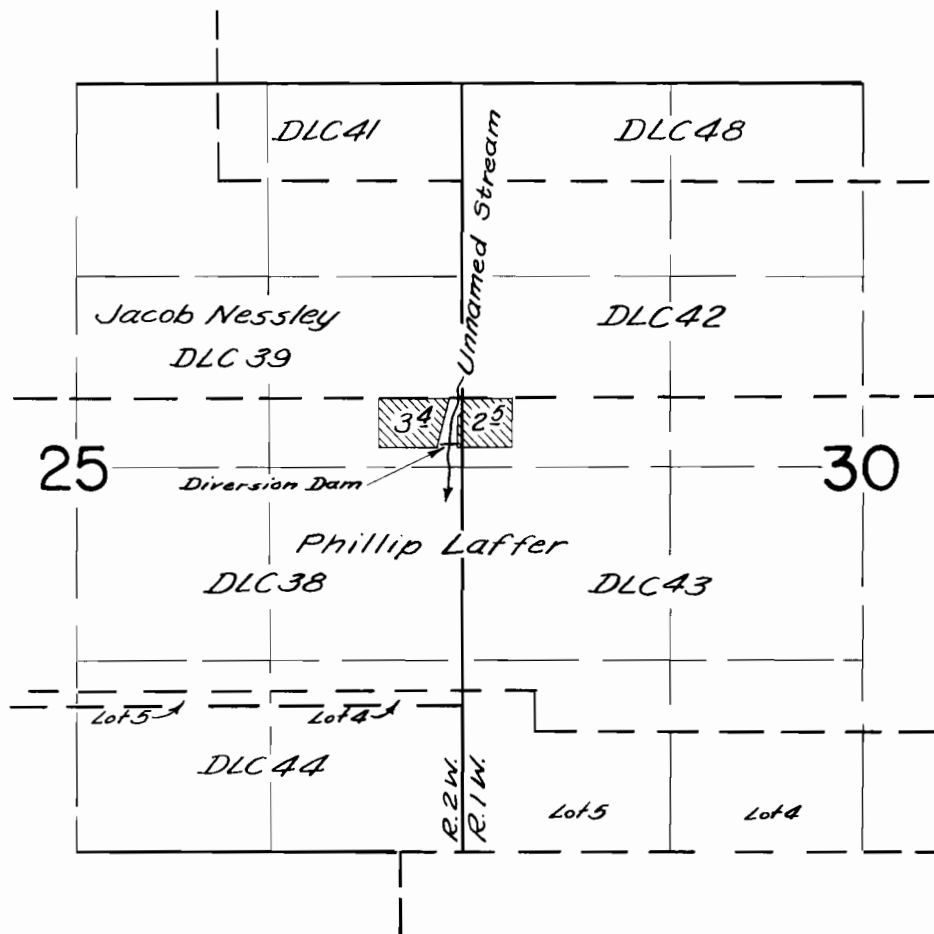

FINAL PROOF SURVEY  
UNDER

Application No. 28283. Permit No. 22239.  
IN NAME OF

*Joseph B. Stephens*

Surveyed July 22 1960, by *C. O. Bartlett*