


# T.15S.R.14E.W.M.

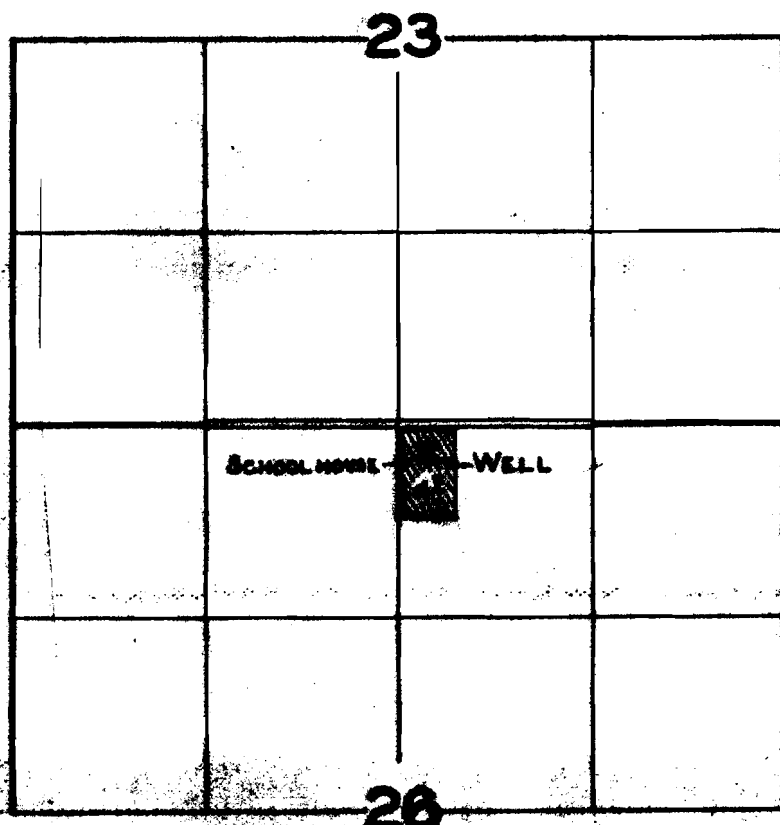

## FINAL PROOF SURVEY

Application No. 5752 Permit No. 5555  
 IN NAME OF  
 CREEK COUNTY SCHOOL BOARD  
 Surveyed OCT. 4, 1960, by M. BISH