


T. 27S. R. 6W. W. M.

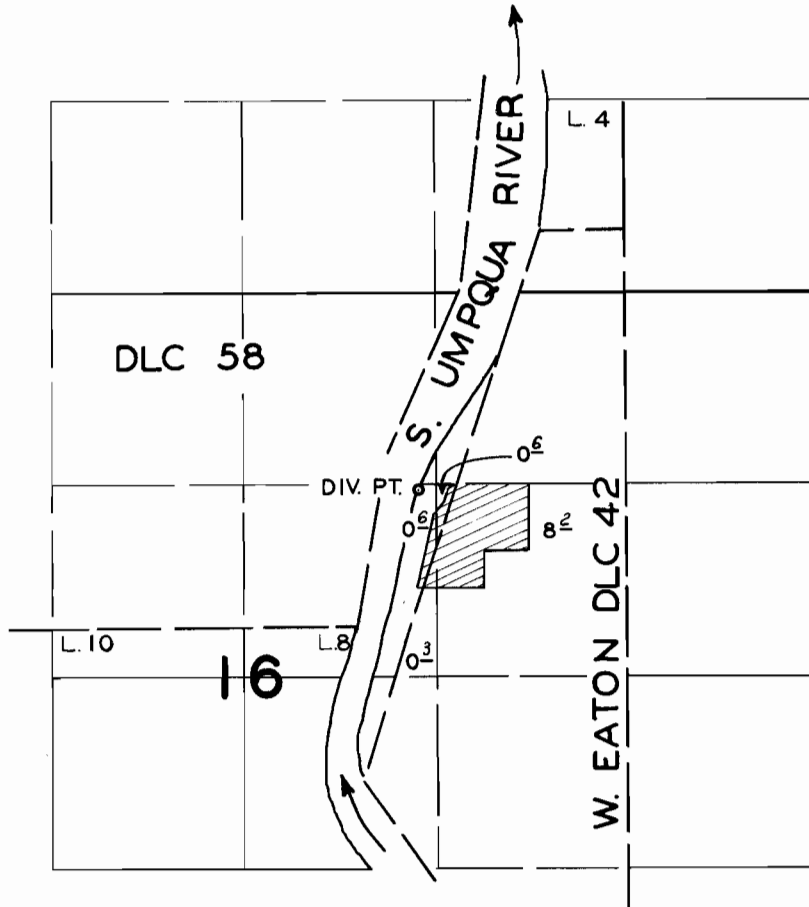

FINAL PROOF SURVEY
UNDER

Application No. 28469 Permit No. 22296
IN NAME OF

THOMAS C. NIEBUHR

Surveyed AUG. 25. 1960, by C. O. BARTELS.