


T. 27S. R. 7W. W.M.

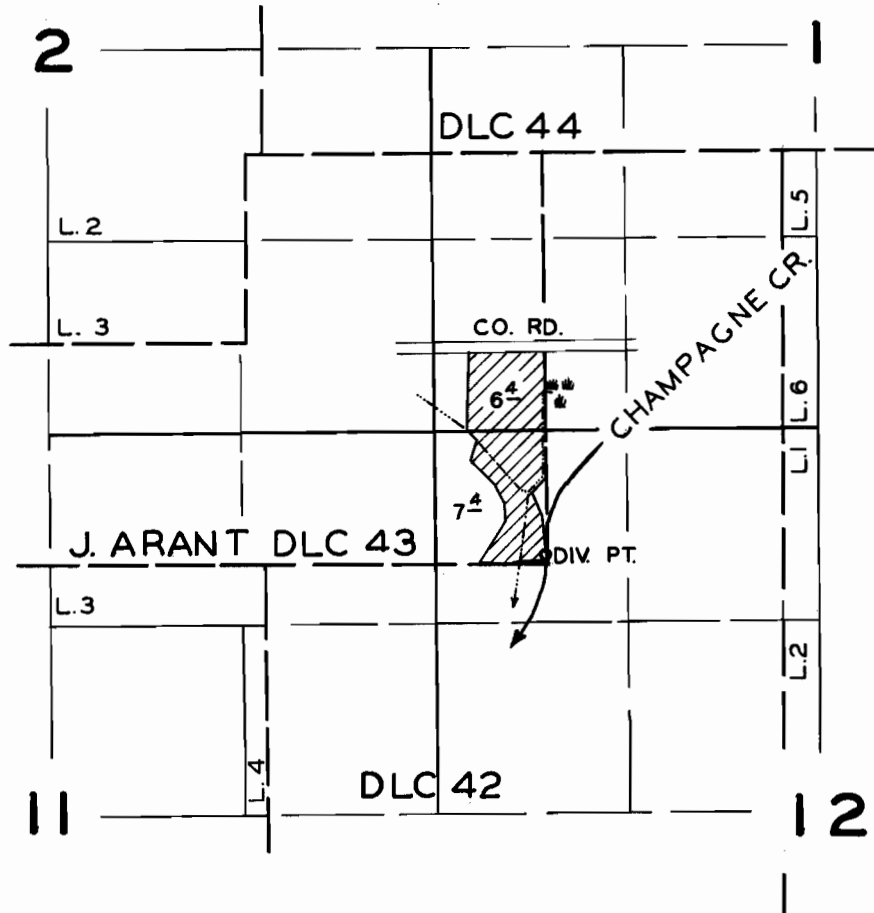

FINAL PROOF SURVEY
UNDER

Application No. 29170 Permit No. 22988
IN NAME OF

RALPH STEWART

Surveyed AUG. 25. 1960. by C.O. BARTELS