


T. 23 S. R. 10 W. W. M.

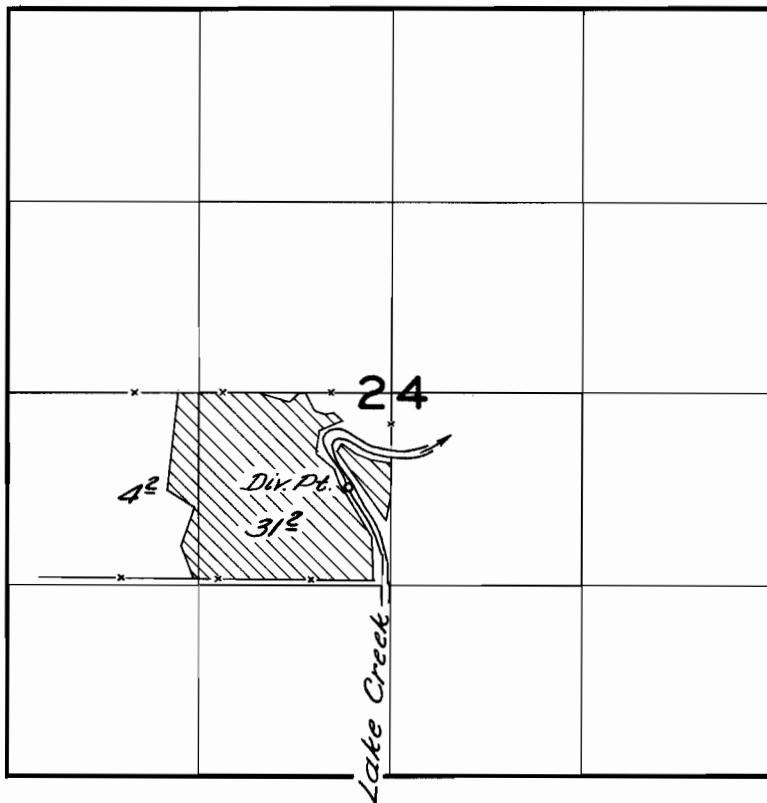

FINAL PROOF SURVEY
UNDER

Application No. 29150... Permit No. 23111.....
IN NAME OF

Nels W. Fredericksen

Surveyed *June 29* 1960, by *C. D. Baile*