


T. 27S. R. 3W. W.M.

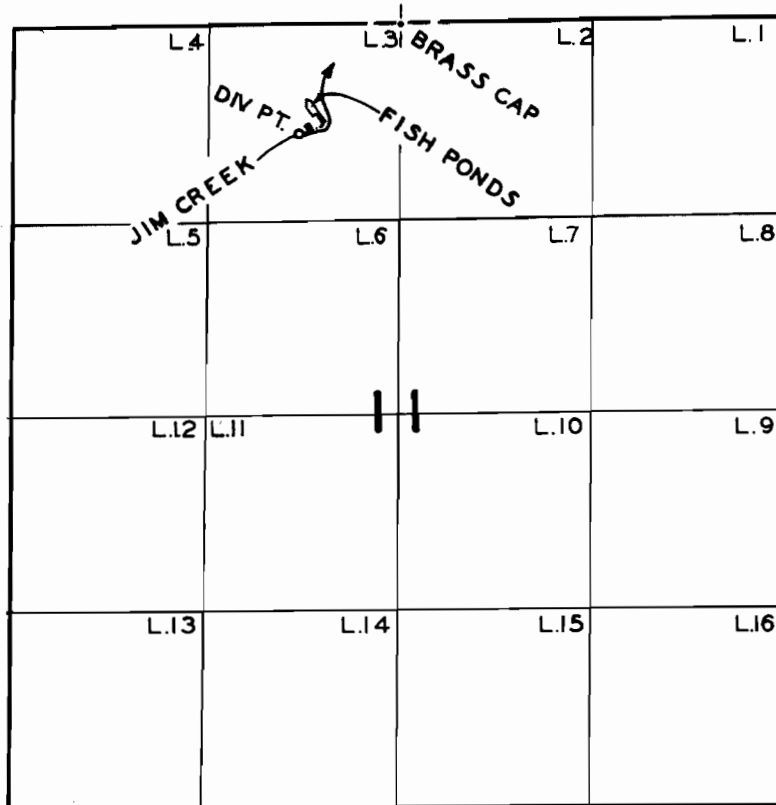

FINAL PROOF SURVEY
UNDER

Application No. ^{R31138} 31054 Permit No. ^{R1931} 24458
IN NAME OF

.....**JOHN MCCAFFREY**.....

Surveyed SEPT. 1... 19.60., by ...C. O. BARTELS

1960 Z *[Signature]*