


T.22S.R.13W.W.M.

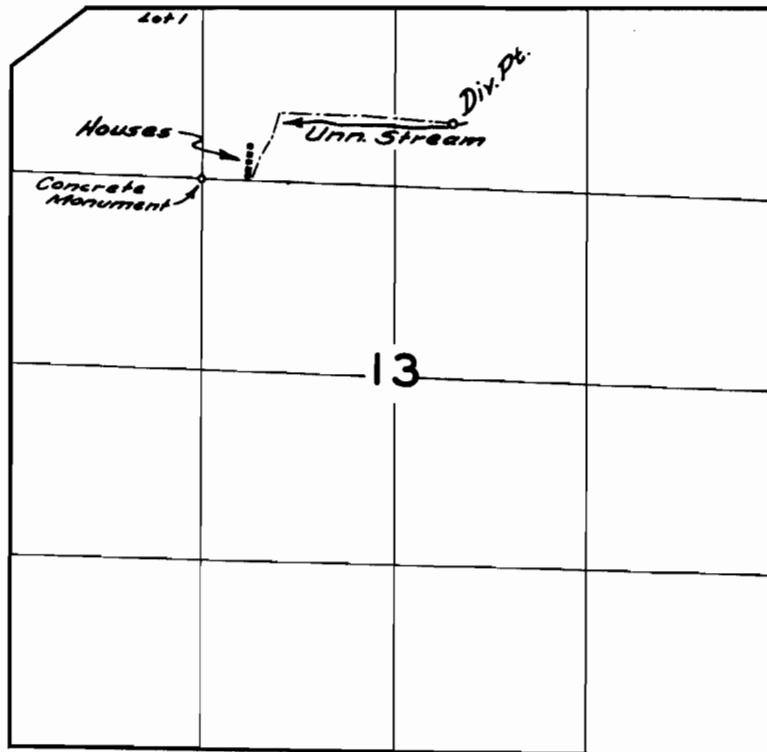

FINAL PROOF SURVEY
UNDER

Application No. 31251 Permit No. 24584
IN NAME OF

Donald S. & Marjorie C. Hughey

Surveyed June 27, 1960, by Chas. L. Smith