


T. 26S. R. 6W.W.M.

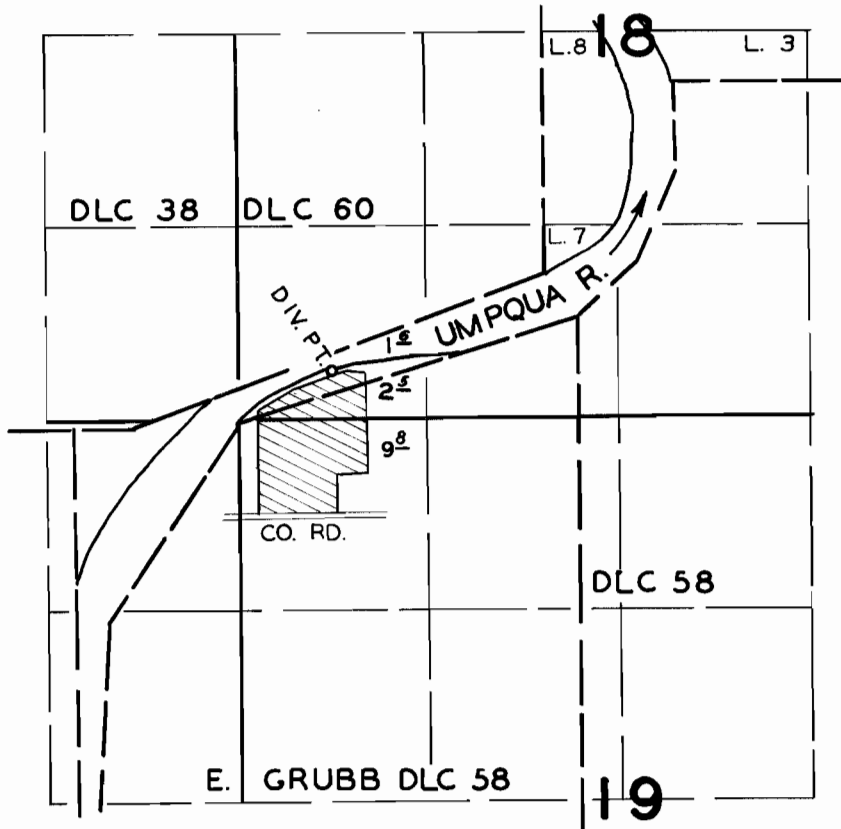

FINAL PROOF SURVEY
UNDER

Application No. 31569 Permit No. 24909
IN NAME OF

G.W. TIPTON

Surveyed AUG. 1960, by C. O. BARTELS