


T.12S. R.5 W.W.M.

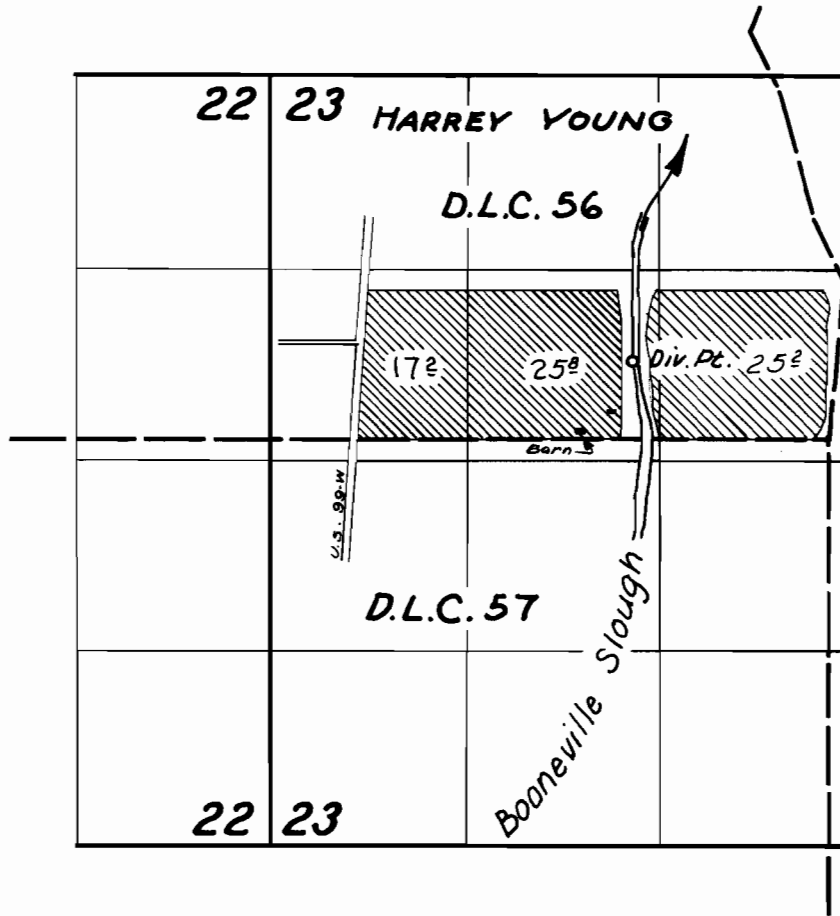

FINAL PROOF SURVEY
UNDER

Application No. 29985. Permit No. 23618.
IN NAME OF

C. E. JONES

Surveyed 24 Sept. 1958, by M. Bish.
July 28 1960 by *[Signature]*

DFJ-3P-52