


T.27S.R.7W.W.M.

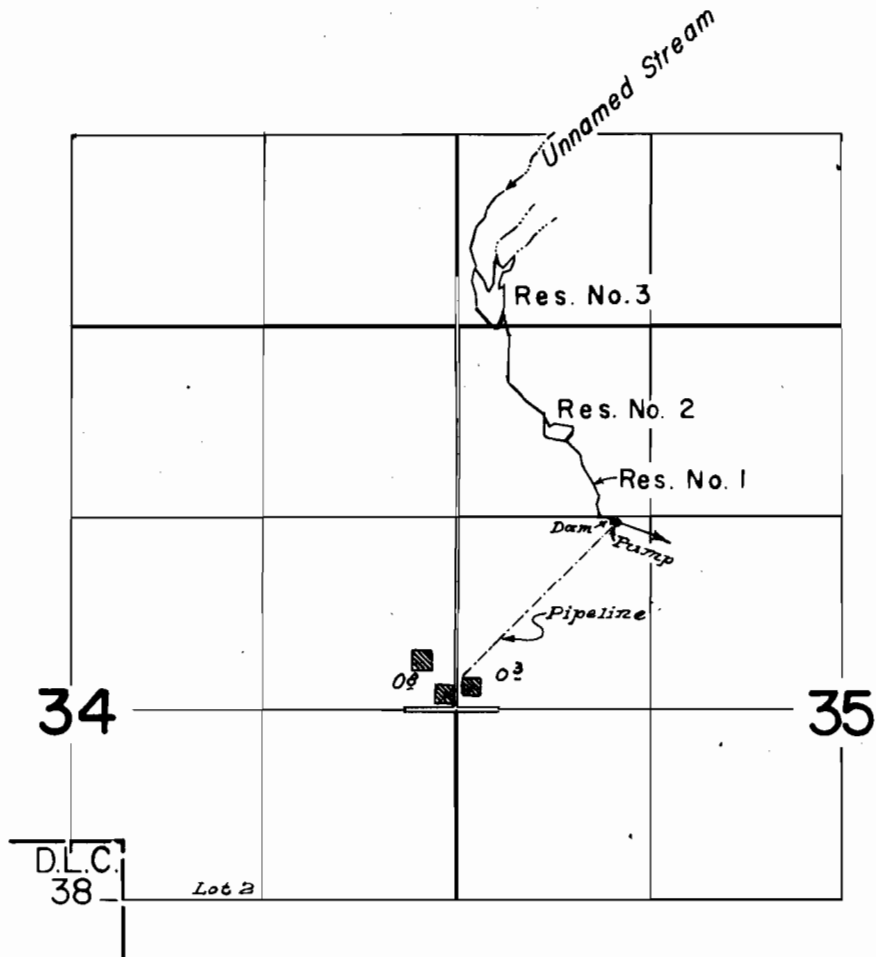

FINAL PROOF SURVEY UNDER

Application No. R-31762 31684 Permit No. R-2080 2514.1
IN NAME OF

Arthur H. & Hazel S. Marsh

Surveyed June 28, 1960, by

R. Jackson