


T.27S.R.7W.W.M.

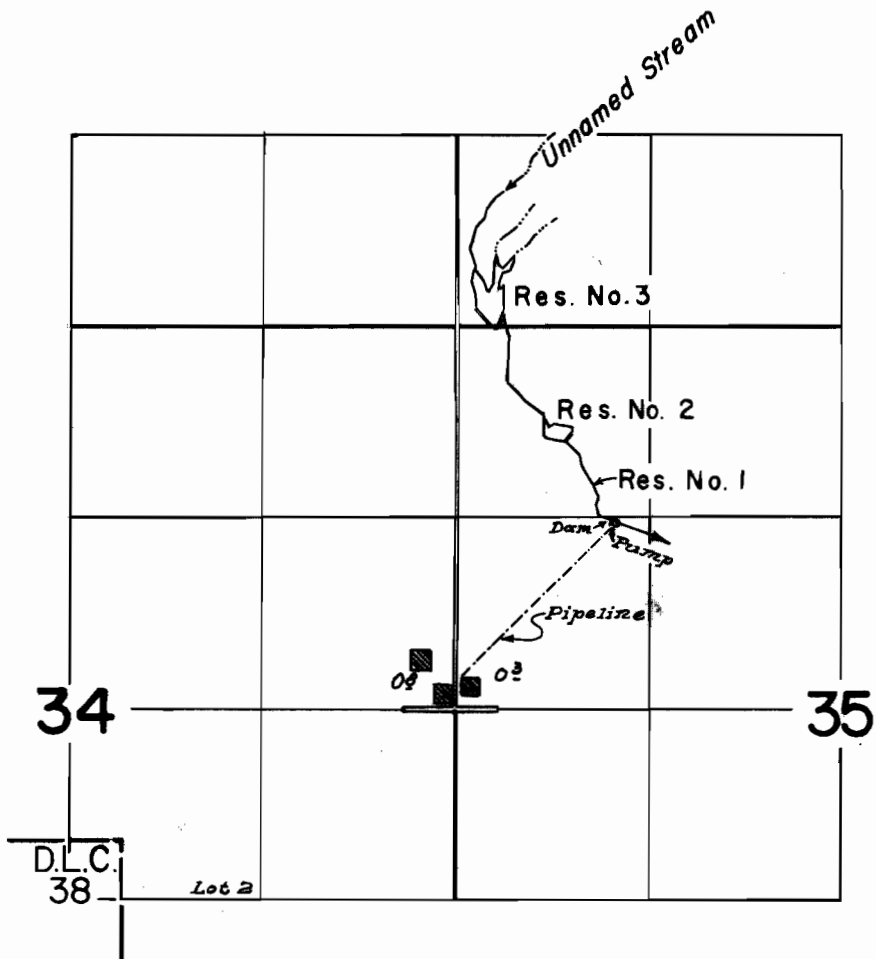

FINAL PROOF SURVEY
UNDER

Application No. R-31762
31684 Permit No. R-2080
2514.1
IN NAME OF

Arthur H. & Hazel S. Marsh

Surveyed June 28, 1960, by R. Jackson