


T.29S. R.8W.W.M.

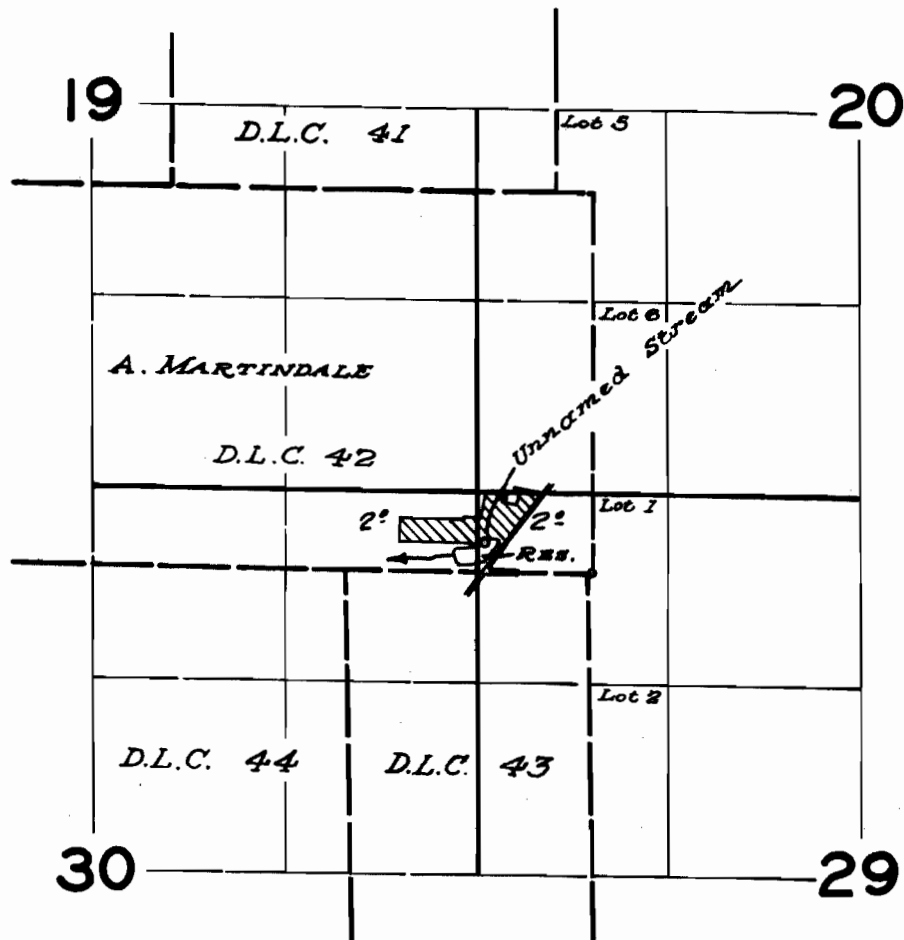

FINAL PROOF SURVEY
UNDER

Application No. *R-31996* *31204* Permit No. *R-2101* *23227*
IN NAME OF

DAVID L. THRUSH

Surveyed *June 29*, 1960., by *RL Jackson*