


T. 38 S. R. 4 W. W.M.

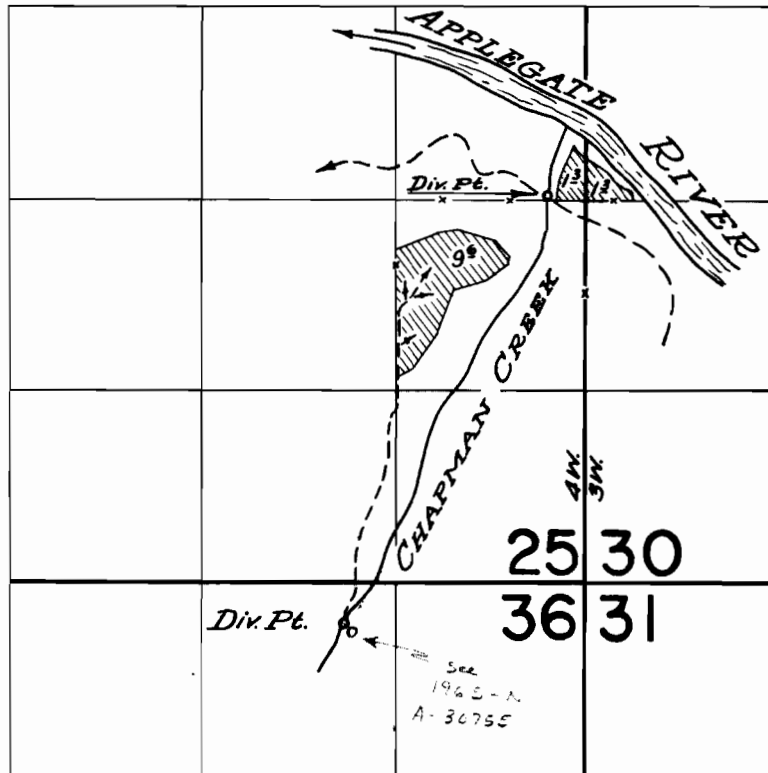

FINAL PROOF SURVEY
UNDER

Application No. 29749.. Permit No. 23432..
IN NAME OF

.....*EVA L. GERHARDT*.....

Surveyed *April 6, 1960,* by *C.O. BARTELS*
Jan. 18 1961 by *D.C. HENDRIX*