


T. 37 S., R. 4 W., W.M.

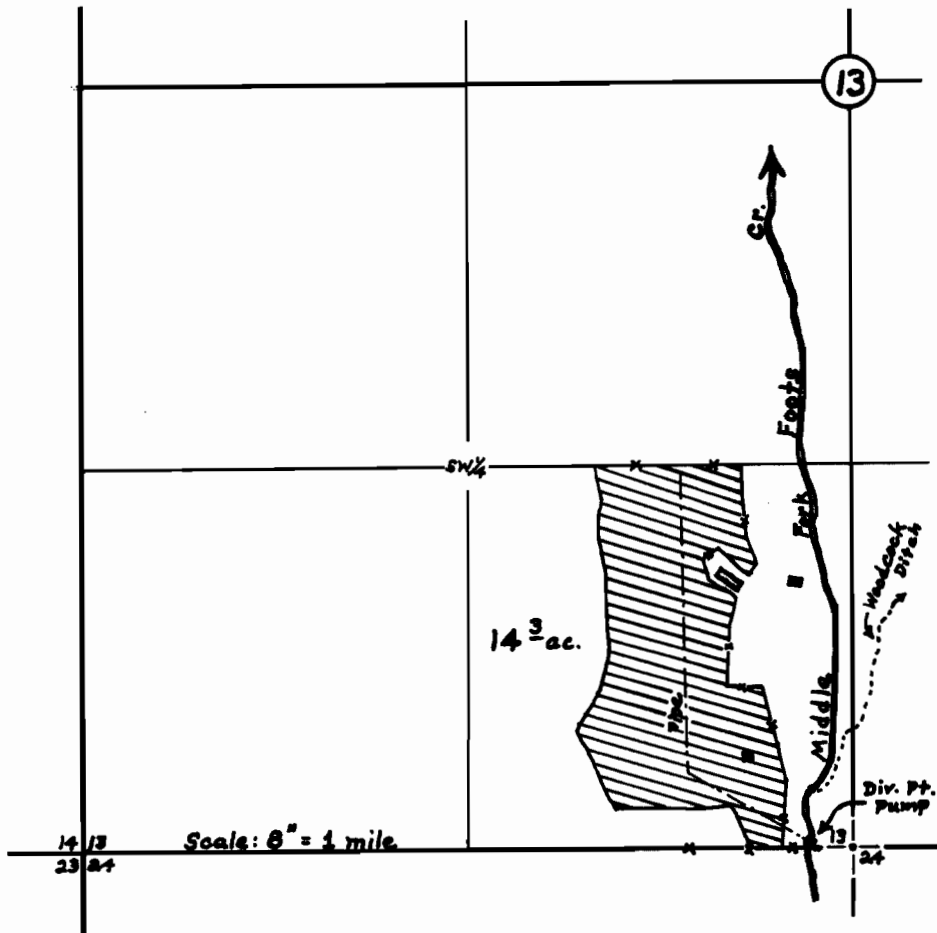

FINAL PROOF SURVEY
UNDER

Application No. 30071..... Permit No. 23701.....
IN NAME OF

.....C. E. Palmer.....

Surveyed Jan. 26 1961., by R. L. Hendrix.....