


T. 38&39S. R. 7&8E.W.M.

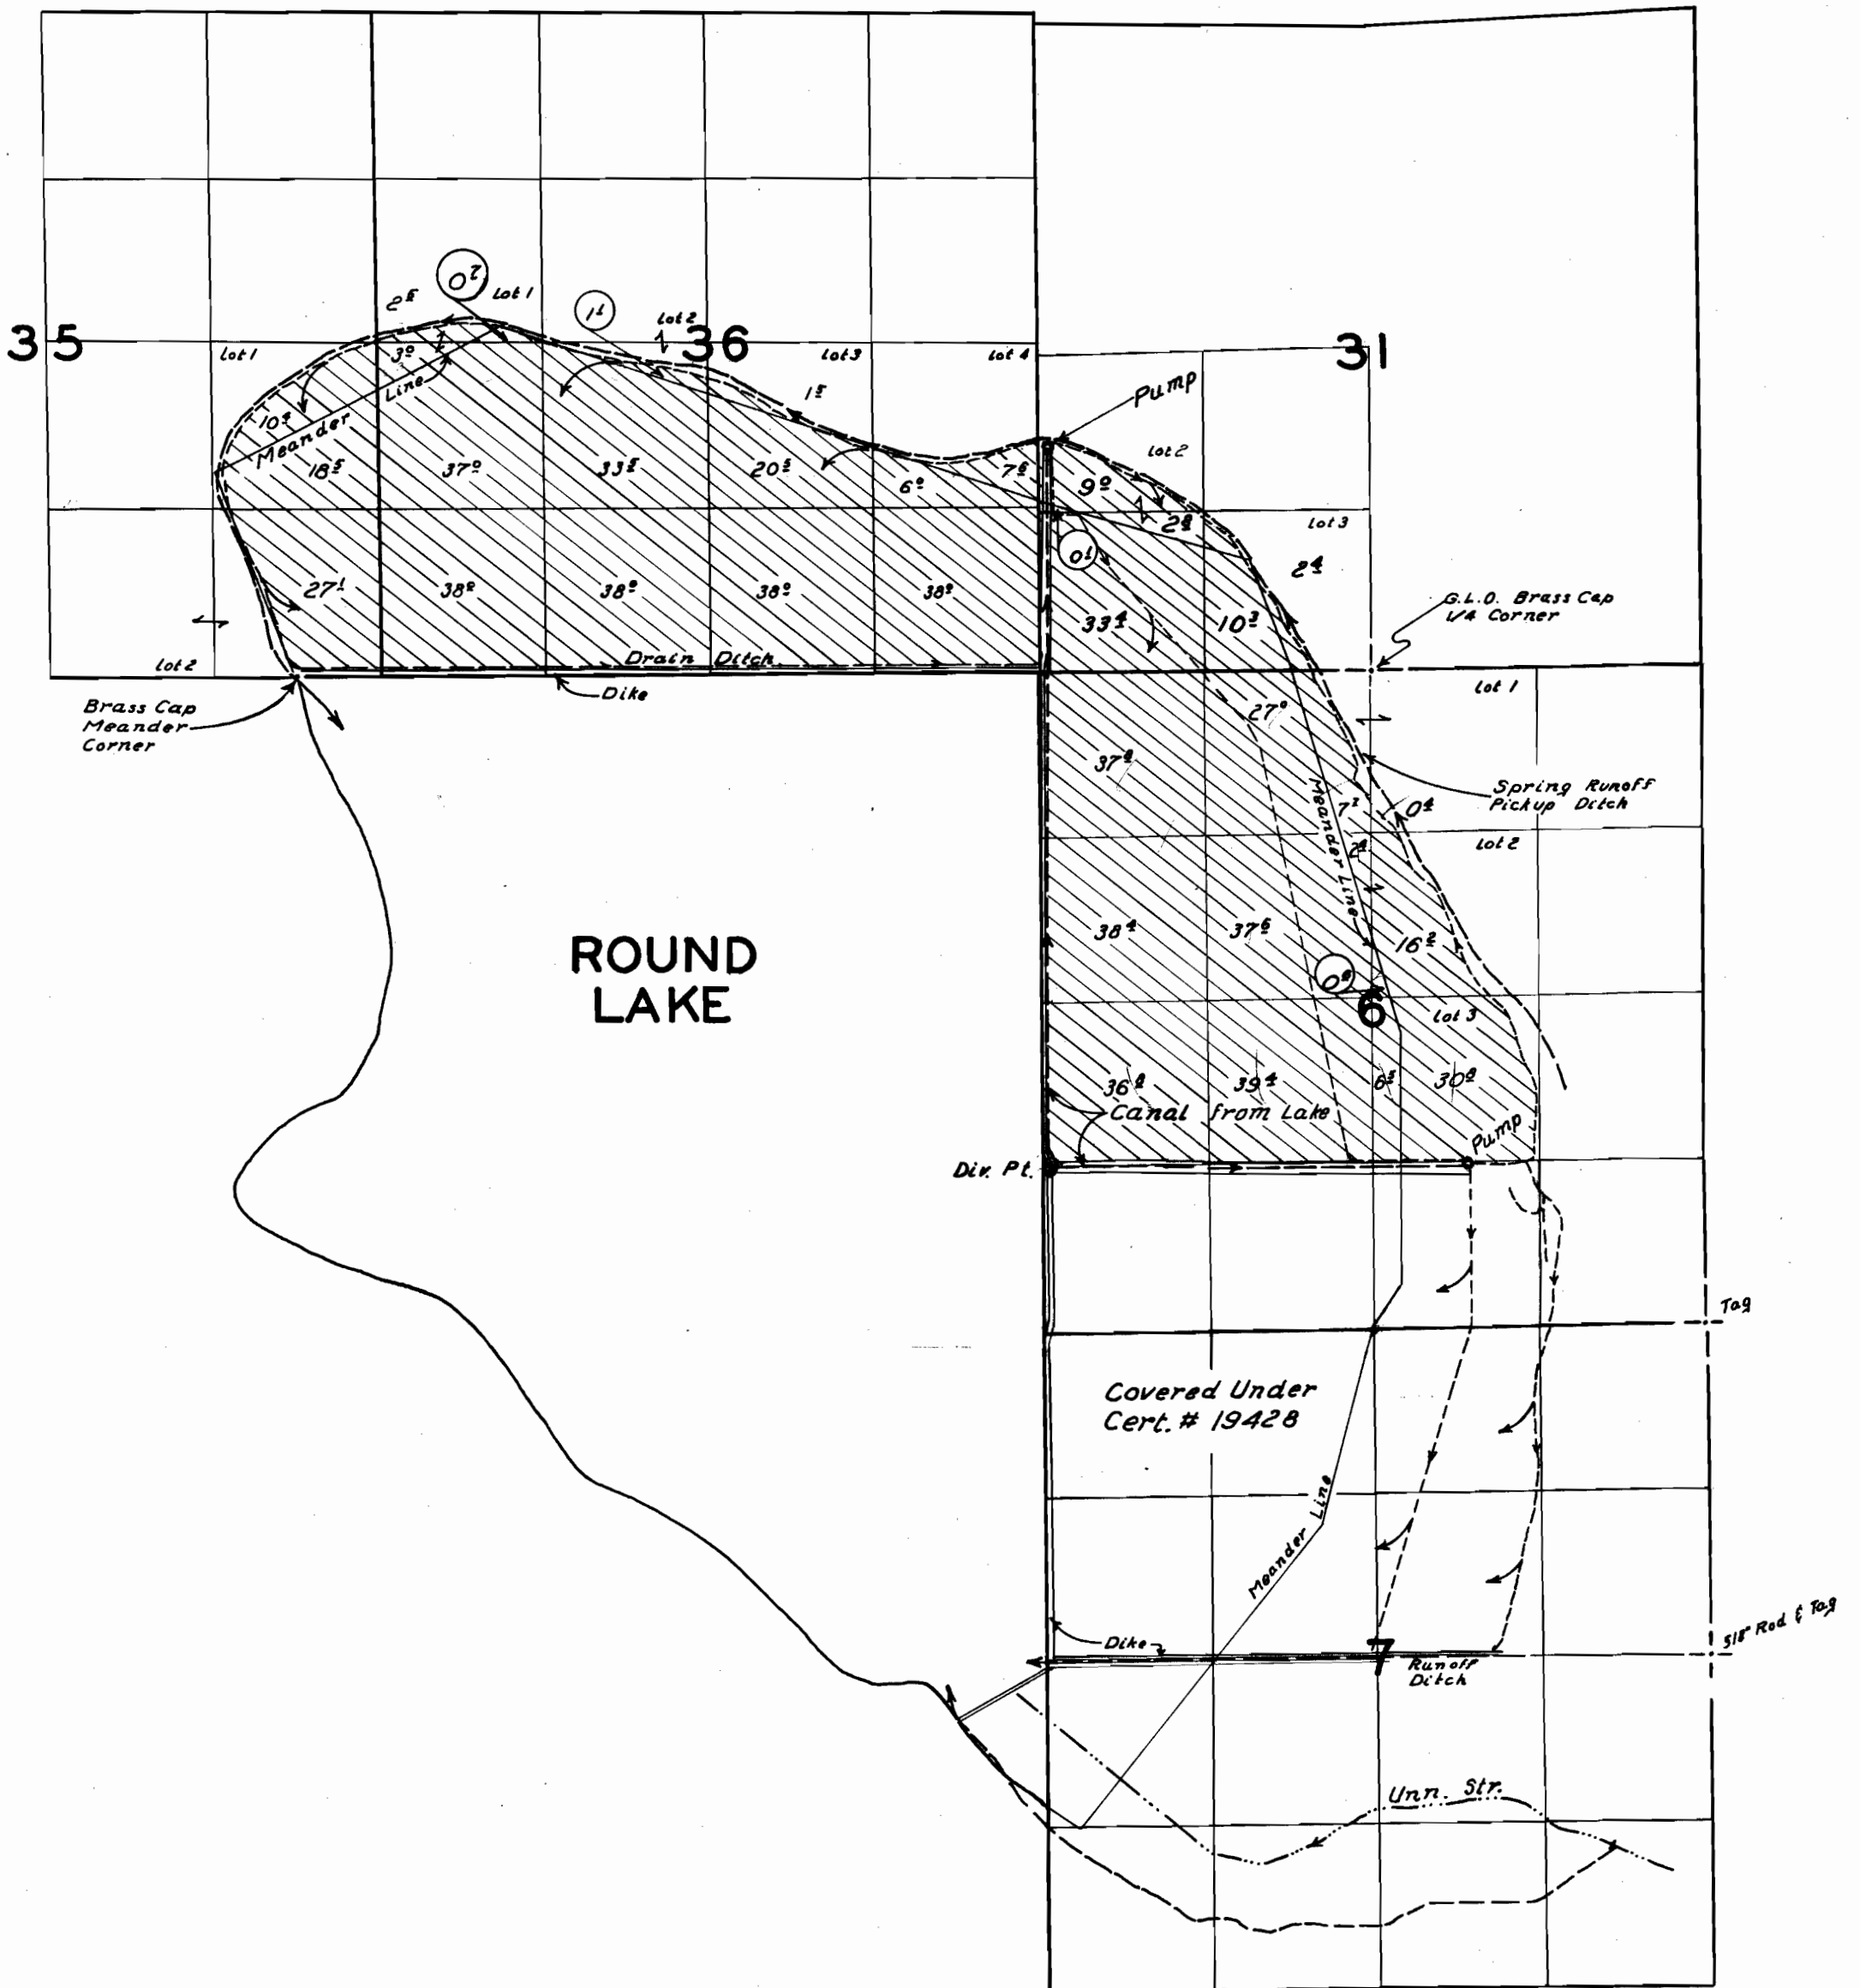

FINAL PROOF SURVEY
under
APPLICATION NO. 28606 PERMIT NO. 22342
IN NAME OF

SURVEYED OCT. 19, 1959, BY R. H. JACKSON