


T.28S.R.7W.W.M.

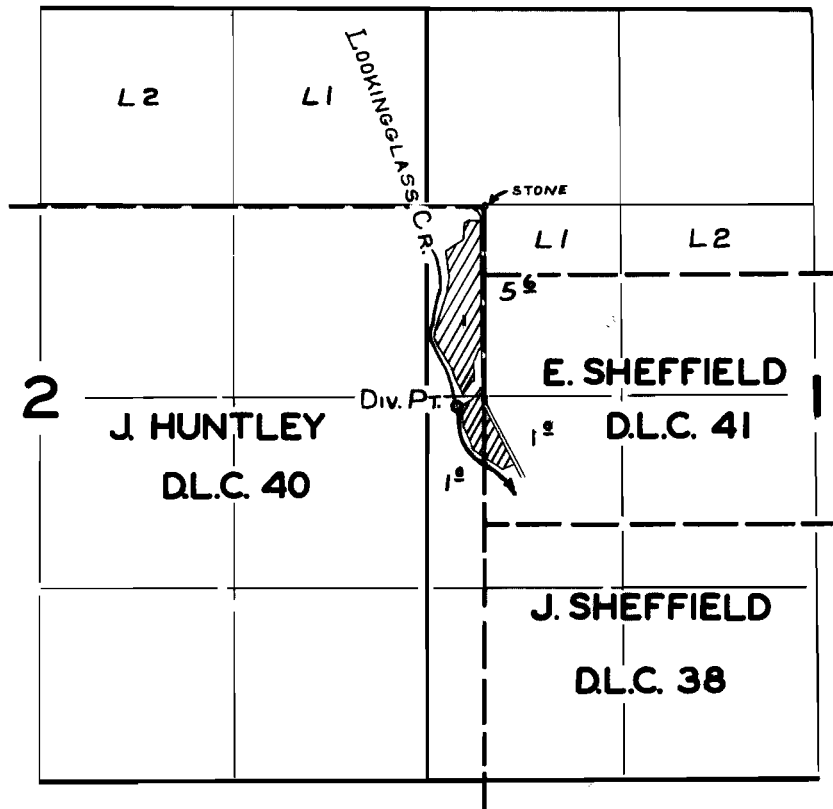

FINAL PROOF SURVEY
UNDER

Application No. 30592... Permit No. 24092...
IN NAME OF

.....RONALD R. MEYER.....

Surveyed JUNE 30 1960, by R. JACKSON.....