


T. 16 S. R. 4 W. W.M.

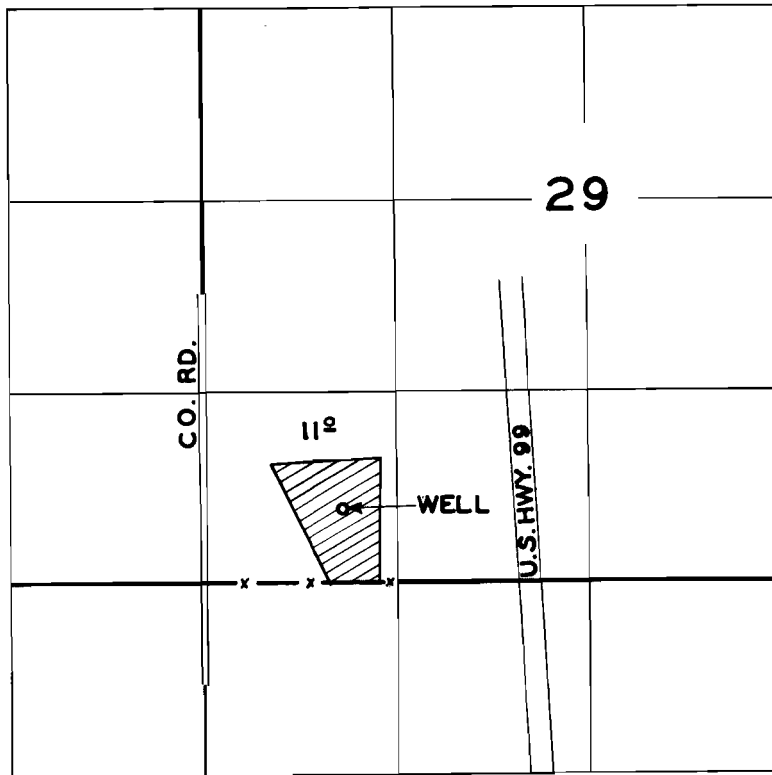

FINAL PROOF SURVEY
UNDER

Application No. G. 330 Permit No. G. 220
IN NAME OF

BEN OR VIRGINIA SIMPSON

Surveyed APRIL 28, 1960, by C. O. BARTELS