


T. 16S. R. 4&5 W. W.M.

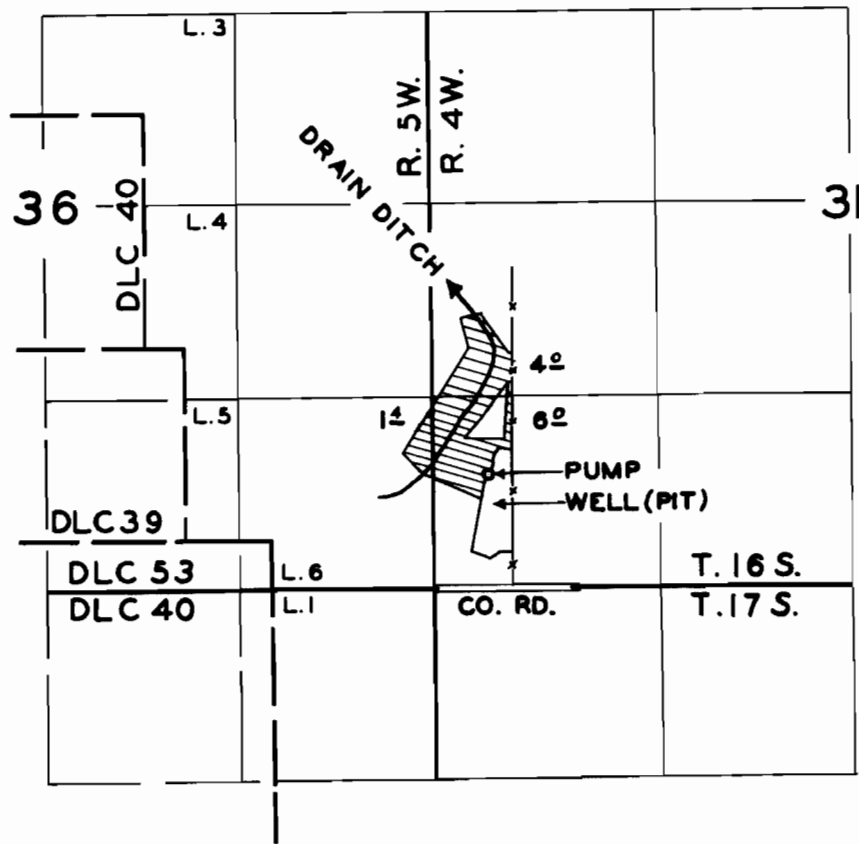

FINAL PROOF SURVEY UNDER

Application No. G.1234..... Permit No. G.1073.....
IN NAME OF

.....ANNJ MERRYMAN.....

Surveyed MAY 5..... 19.60., by C. O. BARTELS.....