


T.16S.R.2E.W.M.

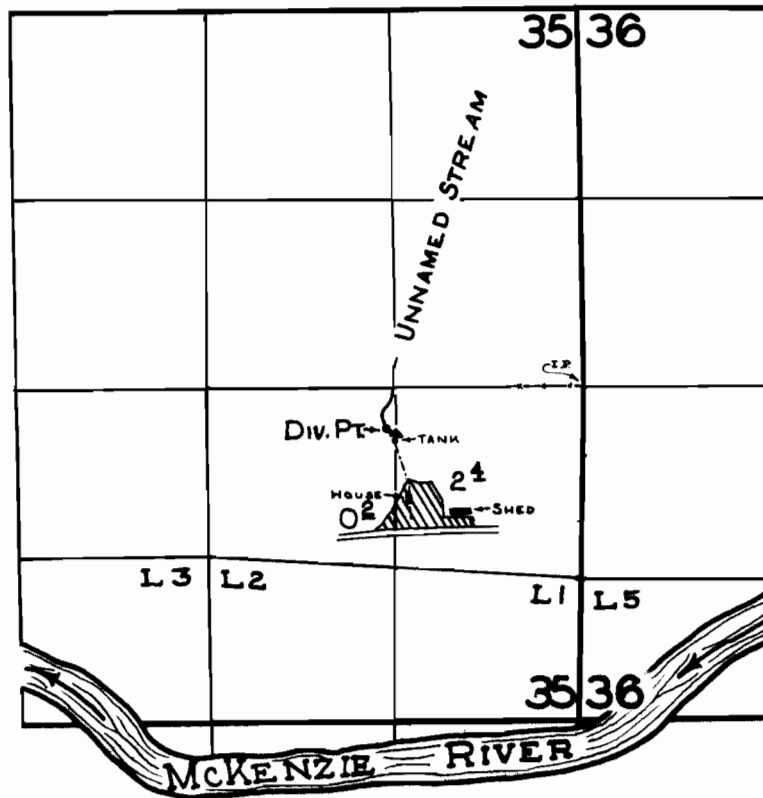

FINAL PROOF SURVEY
UNDER

Application No. 23109 Permit No. 23413
IN NAME OF

..... CLAYTON H. & MABLE M. NESTLE

Surveyed MAY 6 1960, by M. BISH