


# T.17S.R.3W.W.M.

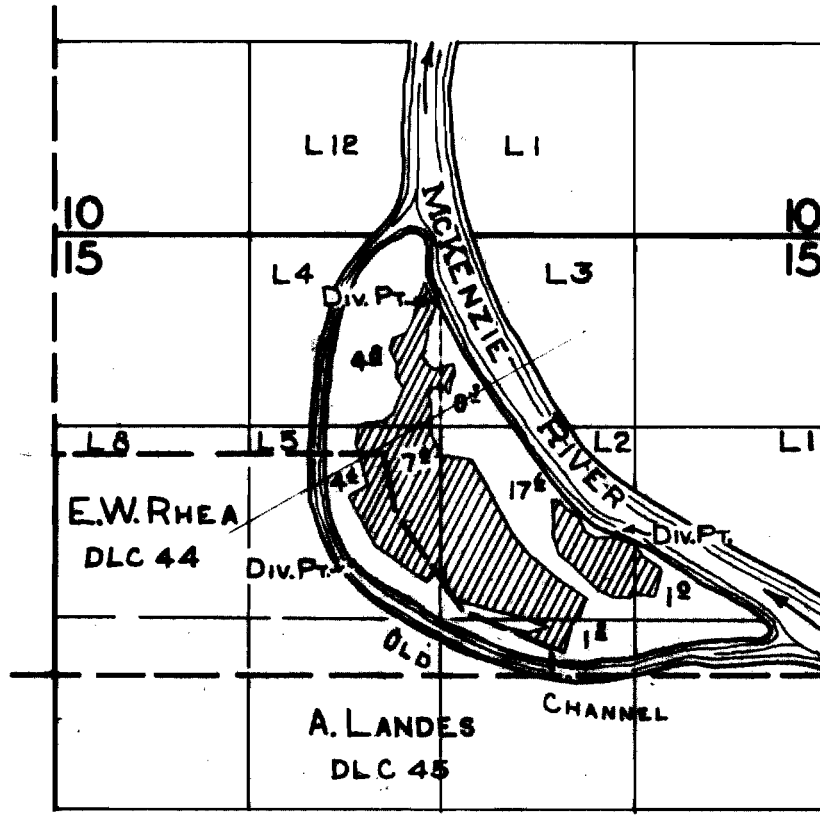

## FINAL PROOF SURVEY UNDER

Application No. 30123... Permit No. 23773...  
IN NAME OF

.....ERIC DOUGLAS WICKLUND.....

Surveyed APRIL 26 1960, by M. BISH.....