


T.21S.R.3&4W.W.M.

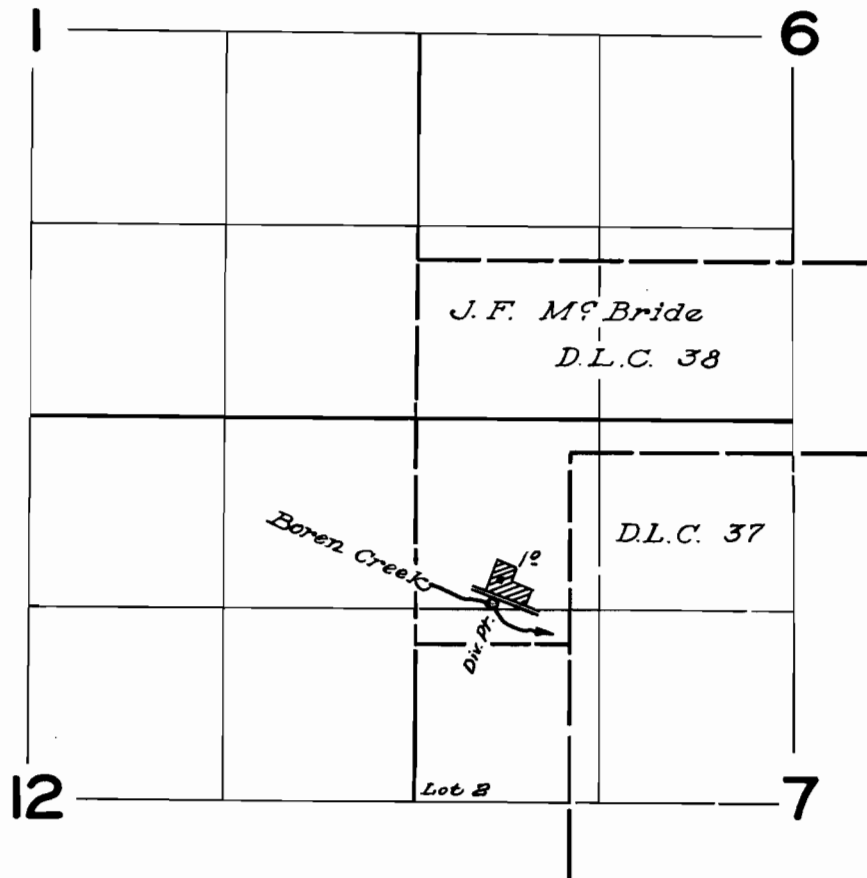

FINAL PROOF SURVEY
UNDER

Application No. 30665 Permit No. 24175
IN NAME OF

ROBERT W. KENADY

Surveyed May 11, 1960, by *R. Jackson*