


T. 21 S. R. 1 W. W. M.

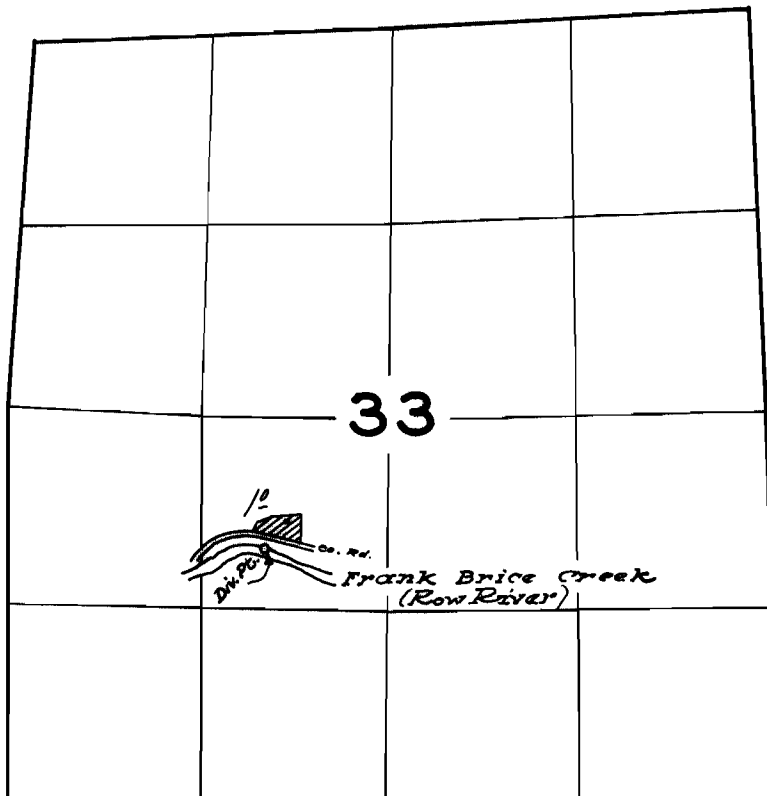

FINAL PROOF SURVEY
UNDER

Application No. 33234 Permit No. 26269.
IN NAME OF

ELTON M. FRITZ

Surveyed May 5, 1960, by R. H. Jackson