


T.12S.R.8W.W.M.

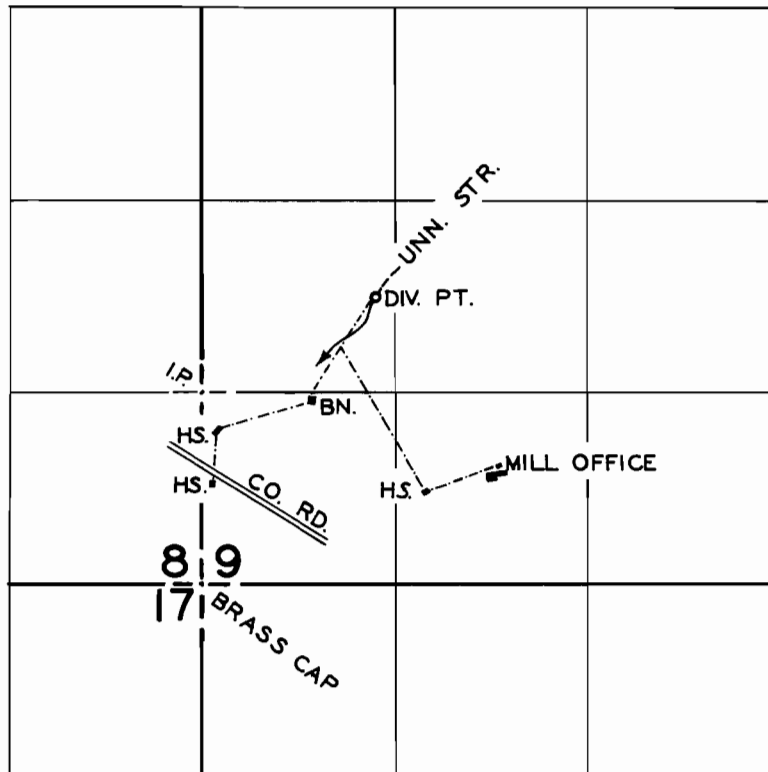

FINAL PROOF SURVEY
UNDER

Application No. 31096 Permit No. 24718
IN NAME OF

DONALD B. & ROSA MAE STOKES

Surveyed AUG. 16 1960, by

[Signature]