


T.8S. R.10W.W.M.

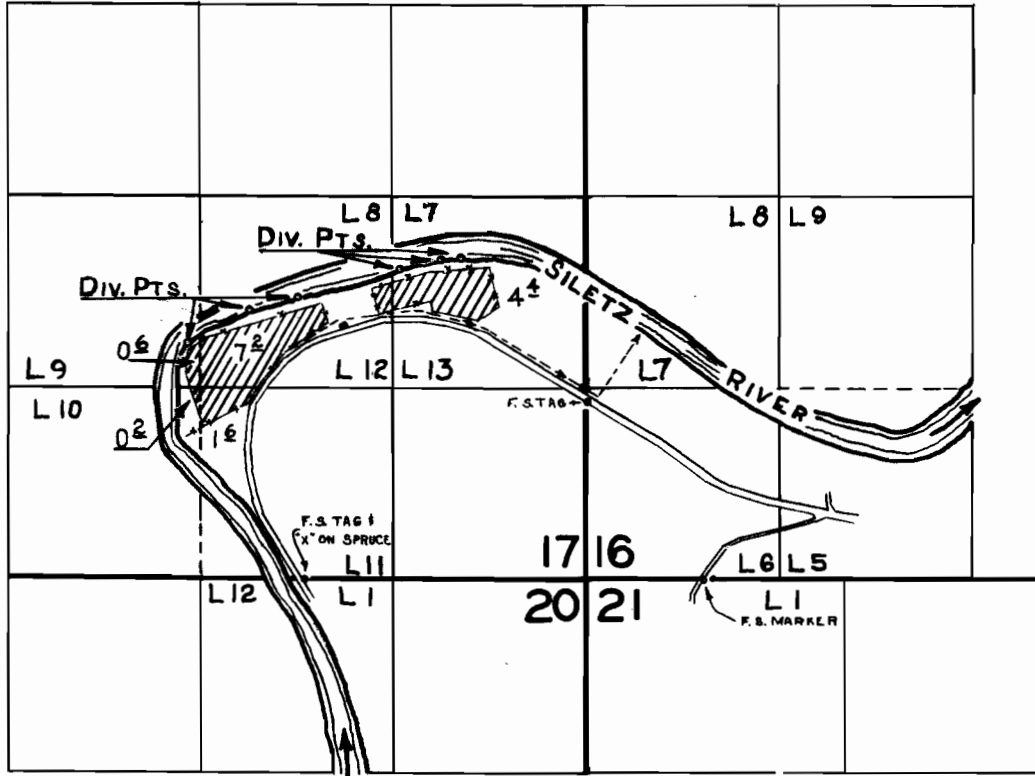

FINAL PROOF SURVEY UNDER

Application No. 31360.. Permit No. 24730.
IN NAME OF

.....**ARDEN E. HOWARD**.....

Surveyed AUG.11... 1960, by M.BISH.....

M.B.