


# T.12 S.R.2 W.W.M.

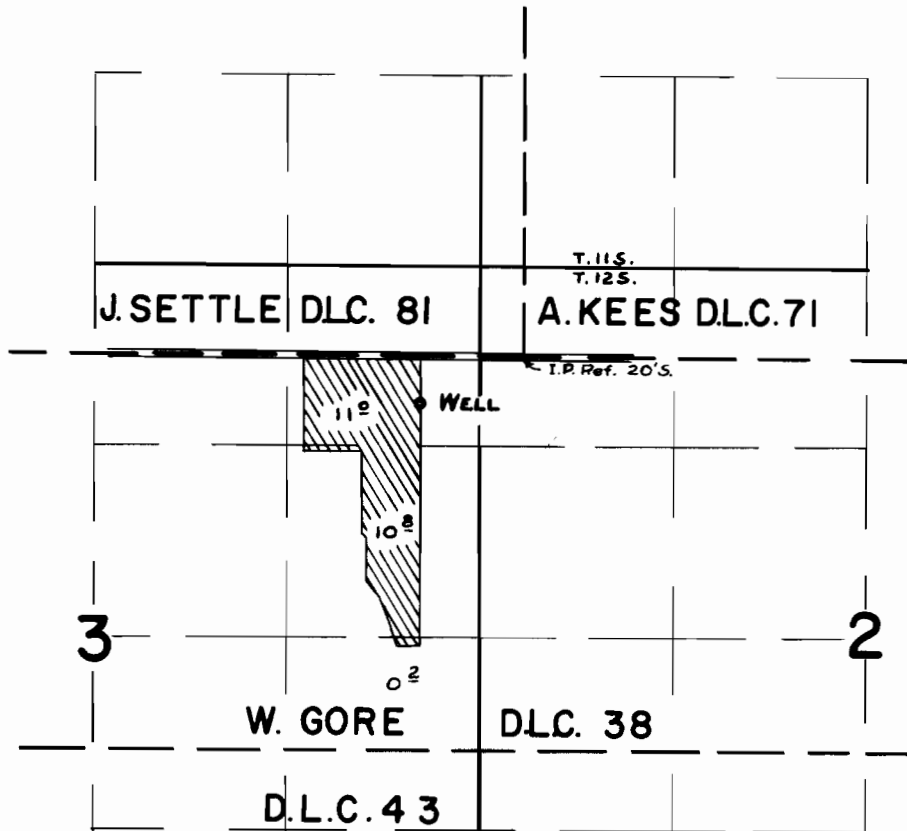

## FINAL PROOF SURVEY UNDER

Application No. G-1007... Permit No. G-899...  
IN NAME OF

ROBERT B. & HELEN K. ALLEY.....

Surveyed 4 Aug. 1960, by *Tom Bish*.....