


T.13S. R.1W.W.M.

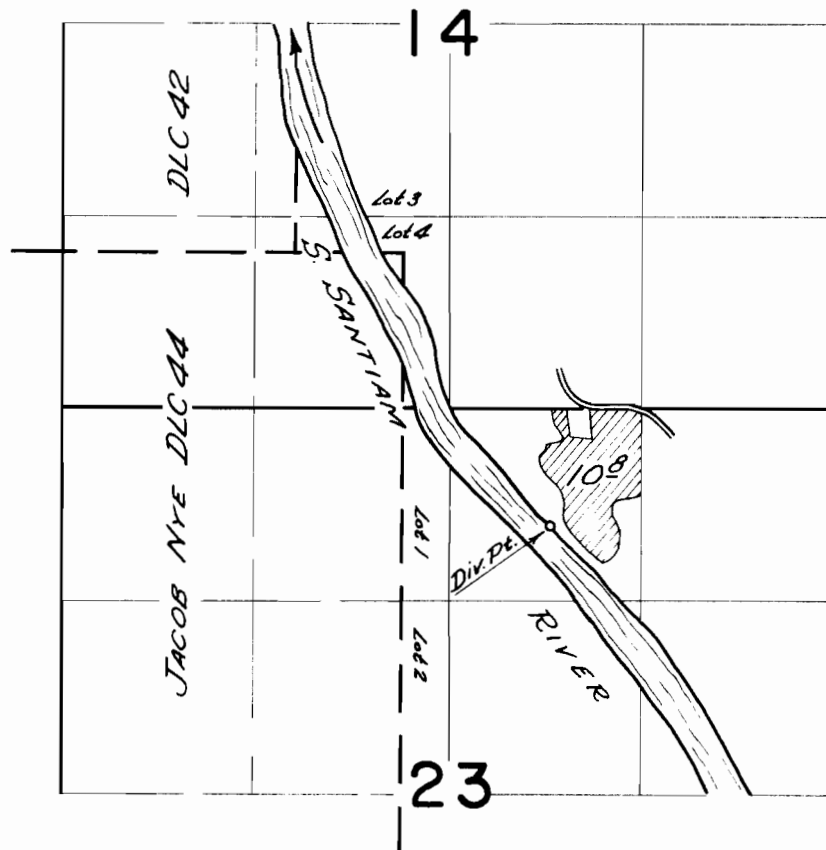

FINAL PROOF SURVEY
UNDER

Application No. 27356 Permit No. 21538
IN NAME OF

W. S. STRUBHAR

Surveyed *Aug. 18* 1960, by *C. O. BARTELS*