


T.12S.R.3W.W.M.

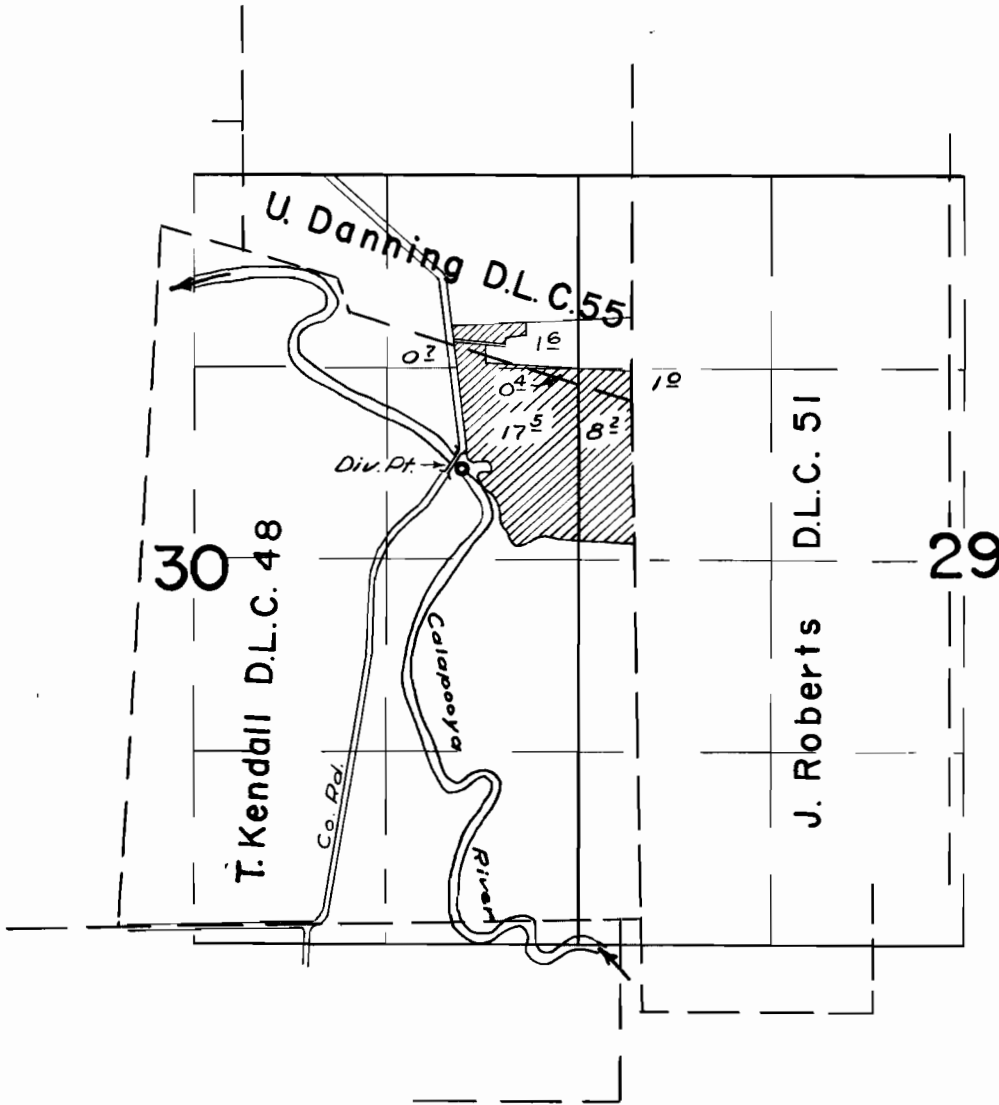

FINAL PROOF SURVEY  
UNDER

Application No. 29952 Permit No. 23597  
IN NAME OF

ERNEST HEYERLY

Surveyed 1 Aug. 1960, by Mr. Bish