


T.I.S. R.I.W.W.M.

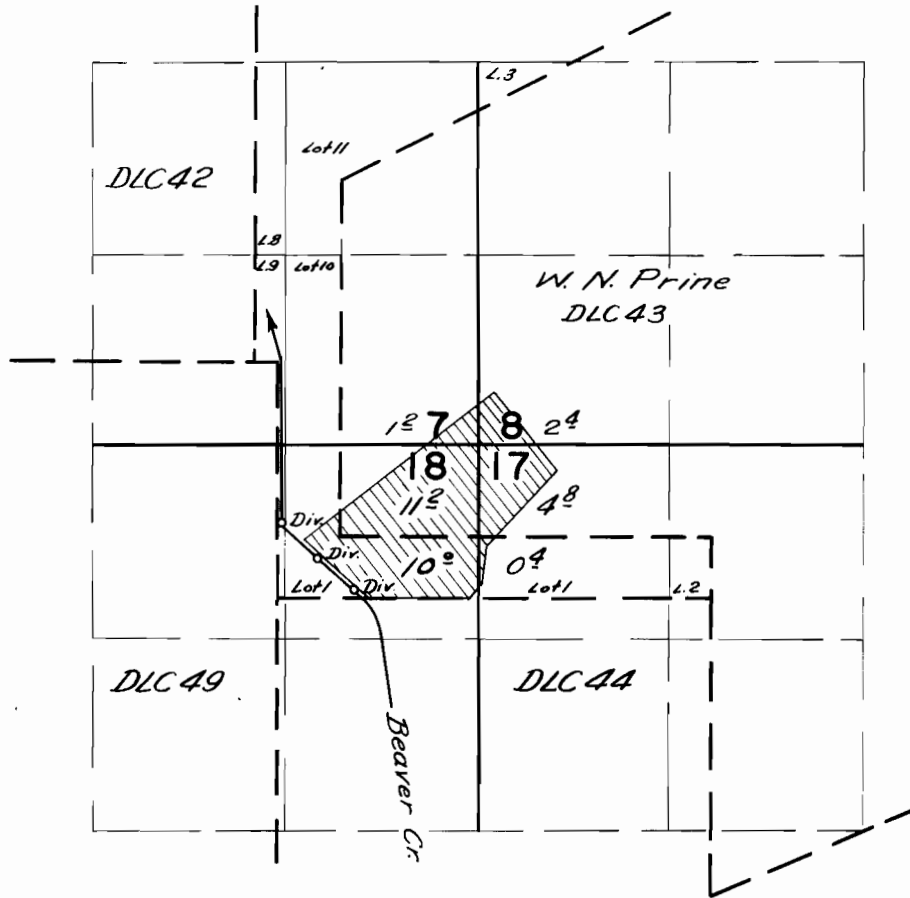

FINAL PROOF SURVEY UNDER

Application No. 30346. Permit No. 23870.
IN NAME OF

..... Lee & Everett Ulm

Surveyed Aug. 19 1960, by C. O. Bartels