


T.9S.R.1W.W.M.

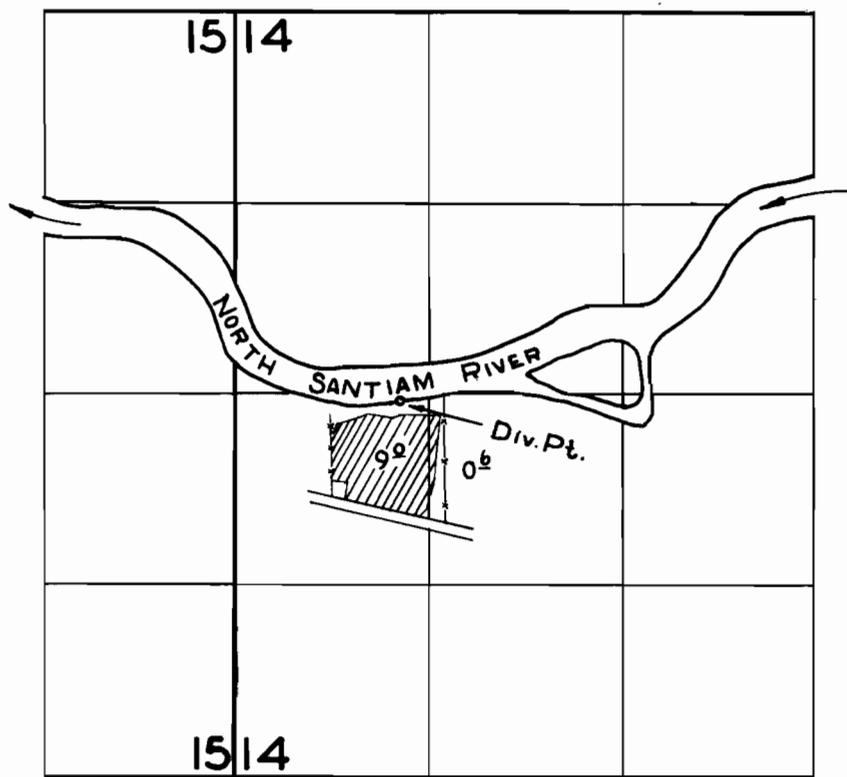

FINAL PROOF SURVEY
UNDER

Application No. 32052. Permit No. 25296..
IN NAME OF

.....RALPH BOEDIGHEIMER.....

Surveyed JULY 7 1960, by M. BISH.....

MB